


DX 78-1

Finney KANSAS

Section 31 Township 25 Range 31W

Well No. 1 Van Derree

Company Petr., Inc.

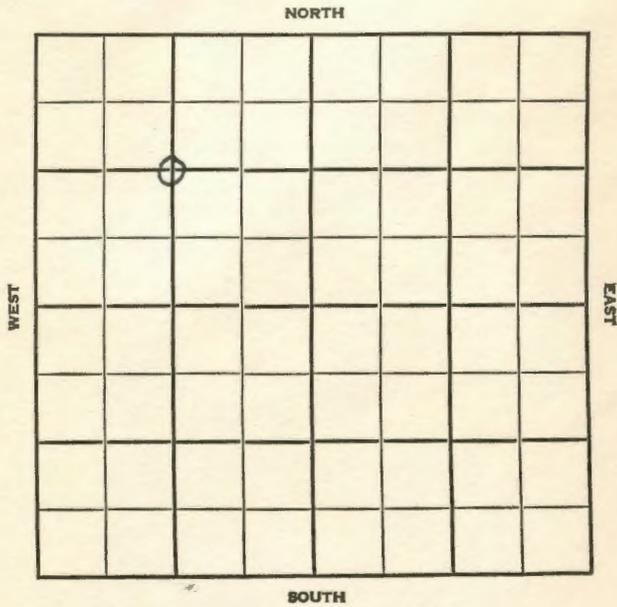

Finney KANSAS

SEC.	TWP.	R.
31	25	31W

WELL NO. 1 Van Derree FARM

COMPANY Petroleum, Inc.

CONTRACTOR


Hugoton Pool

1320 Ft. from N. Line

_____ Ft. from S. Line

_____ Ft. from E. Line

1320 Ft. from W. Line

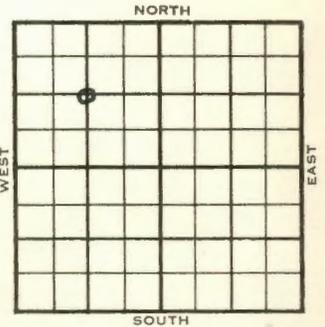

C NW/4

1954	ELEVATION 2850'	REPORT
------	---------------------------	--------

12/29 Spud 12-17-54
Drlg. 2200'

1955
1/26 Spud 12 17-54
Gas Well
TD 2654'
8" @ 400'
Her. 2593' Kri. 2602' Win 2649'
5" @ 2653'
CO 6000 A 250,000 cfg
TD 2654'
frac. 750,000 cfg. 1,770,000 cfg
5 gawph 2000 A 1.975,000 cfg 2000 A
1,800,000 cfg
Comp 7,100,000 cfgpd. 401#

COMPLETED

County Finney State Kansas

Sec. 31 (Blk. 25 (Sur. 31W Map No.

Operator Petroleum Inc.

Well No. 1 Farm Van Derree

Elev. 2850 Location C NW/4



1320 Ft. From N Line NW

1320 Ft. From W Line Quarter

1st. Report

Completion JAN 26 1955

Remarks Hugoton Pool

Spudding Date 12-17-54

Drlg. Data Gas well TD 2654

8" @ 400 Her. 2593 Kri. 2622

Win. 2649 5" @ 2653 CO 6000 A

250,000 cfg TD 2654 frac 750,000 cfg

1,770,000 cfg 5 gawph 2000 A

1,975,000 cfg 2000 A 1,800,000 cfg

Comp. 7,100,000 cfgpd 401#

FABEN GILSTRAP


County Finney State Kansas

Sec. 31 (Blk. 25 (Sur. 31W Map No.

Operator Petroleum Inc.

Well No. 1 Farm Van Derree

Elev. 2850 Location C NW/4

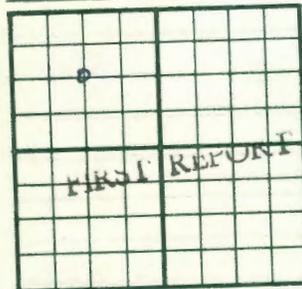

1320 Ft. From N Line NW

1520 Ft. From W Line Quarte

1st. Report DEC 29 1954

Completion

Remarks

Spudding Date 12-17-54

Drlg. Data Hugoton Pool

drlg. 2200

FABEN GILSTRAP