

Finney

KANSAS

Sec. 4 Twp. 25 R. 32W

Well No. #1 Celona O. Hicks Farm

Magnolia Company

Contractor


330' Ft. from N. Line

Ft. from S. Line

Ft. from E. Line

330' Ft. from W. Line

NW NW SE

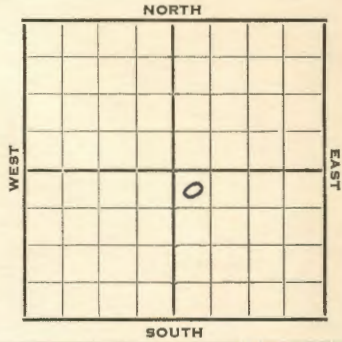

1952 **Elev. 2883'** REPORT

4/30 Location
 5/7 Drlg. 830'
 5/14 10" @ 919'
 Drlg. 2575'
 5/21 **Krider 2564'** **Winfield 2620**
Up Ft 2743
 RTD 2750' 6" @ 2747' CO
 5/28 48/2680-94 7000 A 120/2622-50
 7000 120/2590-2606, 2570-2586
 7000 A
 6/11 Spud 5-5-52
 Gas well TD 2750 10" @ 919
Kri 2564 **Win. 2620**
Ft. Riley 2743
 6" @ 2747 48/ 2680-94 7000 A
 120/ 2622-50 7000 A 120/ 2590-2606
 & 2570-2586 7000 A
 Comp. 4,090,000 gas

COMPLETED

Finney

KANSAS

Section 4 Township 25 Range 32 W

Well No. # 1 Celona O. Hicks

Company Magnolia

