

Finney

KANSAS

Sec. 5 Twp. 25 R. 32W

Well No. #1 Burnside "A" Farm

Magnolia Pet. Company

Brack - Contr. Contractor


330' Ft. from N. Line

Ft. from S. Line

Ft. from E. Line

330' Ft. from W. Line

NW NW SE

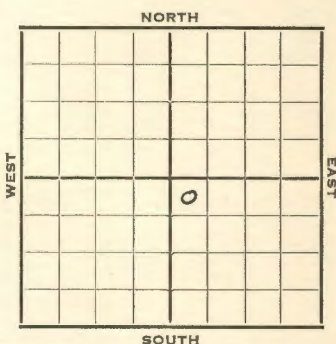

1952 **Elev. 2867'** REPORT

4/23 RUR
11/30 10" @ 959'
Drlg. 2577'
5/7 Her. 2505 Krider 2536
Winfield 2596 Towanda 2655
Ft. Riley 2716 RTD 2750
6" @ 2750 w/1000
5/14 48/ 2662-72 72/ 2598-2618
14,000 A
5/21 32/ 2574-80 7000 A 72/ 2544-60
7000 A
5/28 NR
6/4 Spud 4-23-52
Gas Well T^W 2750 10" @ 959'
Her. 2505 Kri. 2536
Win. 2596 Tow. 2655
Ft. Riley 2716
TD 2750 6" @ 2750 48/ 2662-72
72/ 2598-2618 14,000 A 32/ 2574-80
7000 A 72/ 2544-60 7000 A
Comp. 4,090,000 gas


COMPLETED

FORM 51 25M 3-49 PETROL Finney KANSAS

Section 5 Township 25 Range 32 W

Well No. # 1 Burnside "A"

Company Magnolia Pet.

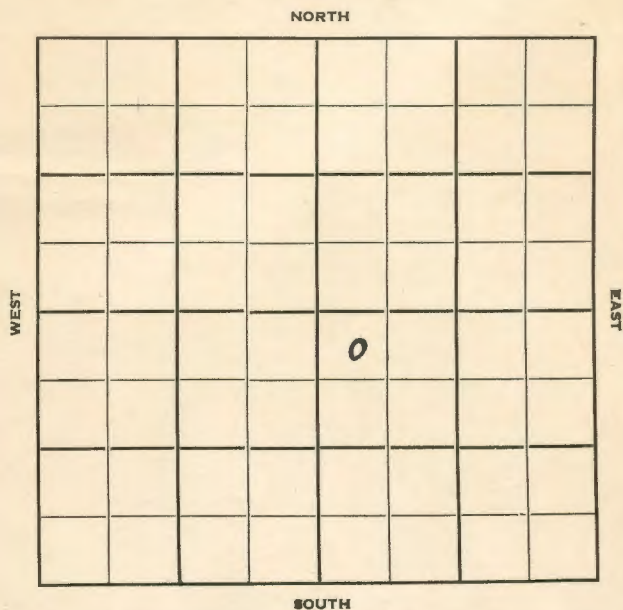

County **Finney** State **Kansas**
 Sec. **5** (Blk.) **25** (Sur.) **3 2W** Map No.

Operator **Magnolia Pet.**

Well No. **1** Farm **Burnside "A"**

Elev. Location **NW NW SE**

330 Ft. From **N** Line **SE**

330 Ft. From **W** Line Quarter

1st. Report **APR 23 1952**

Completion

Remarks

Brack - Contr.

Spudding Date

Drig. Data

BUR

J. G. McGEHEE

County **Finney** State **Kansas**
 Sec. **5** (Blk.) **25** (Sur.) **32W** Map No.

Operator **Magnolia Pet.**

Well No. **1** Farm **Burnside "A"**

Elev. **2867** Location **NW NW SE**

330 Ft. From **N** Line **SE**

330 Ft. From **W** Line Quarter

1st. Report

Completion **JUN 4 1952**

Remarks

Brack - Contr.

Spudding Date **4-23-52**

Drig. Data **Gas well TD 2750**

10" @ 959 Her. 2505 Kri. 2536

Win. 2596 Tow. 2655 Ft. Riley 2716

TD 2750 6" @ 2750 48/ 2662-72

72/ 2598-2618 14000 A 32/ 2574-80

7000 A 72/ 2544-60 7000 A

Comp. 4,090,000 gas

J. G. McGEHEE