

Finney KANSAS

SEC. 2 TWP. 25 R. 32 W

WELL NO. # 1 Hicks Gas Unit "B" FARM

COMPANY Stanolind

CONTRACTOR Noble Drlg.
Hogoton Pool


150 Ft. from N. Line

150 Ft. from S. Line

150 Ft. from E. Line

150 Ft. from W. Line

SW SW NE

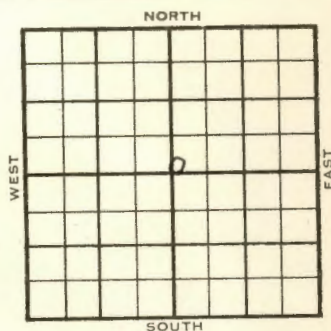

1954	ELEVATION	REPORT
12/1	2840'	Location
1955 1/12		Spud 12-5-54 - Gas Well TD 2622' 8" @ 920' Her. 2544', Kri. 2572', Win. 2607' TD 2622' 5" @ 2607' CO to 2622 Jet-frac, 1,640,000 cfg 60 gawph SP 2590, 12/2546-48, 192/2550-82 Jet-frac, SP 2622 2,009,000 cfg comp. 4,169,000 cfg, 315#

COMPLETED

Finney


DX 78-1

KANSAS


Section 2 Township 25 Range 32W

Well No. #1 Hicks Gas Unit "B"

Company Stanolind

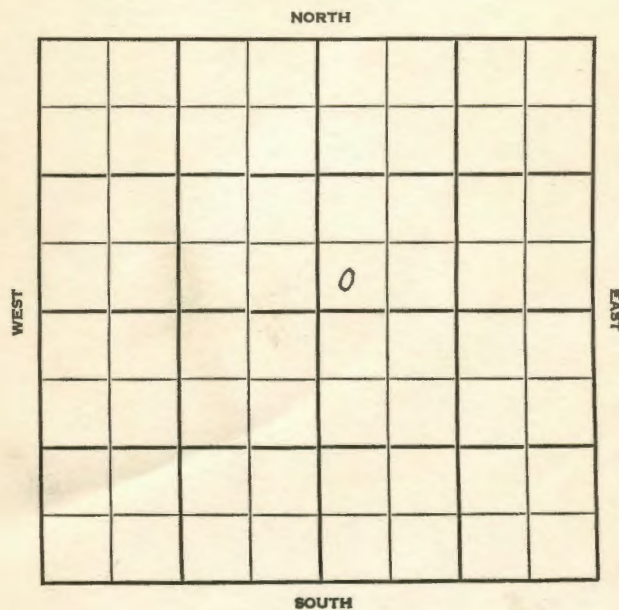

County **Finney** State **Kansas**
 Sec. **2** (Blk. **25** (Sur. **32W** Map No.
 Operator **Stanolind**
 Well No. **1** Farm **Hicks Gas Unit "B"**
 Elev. **2840** Location **SW SW NE**

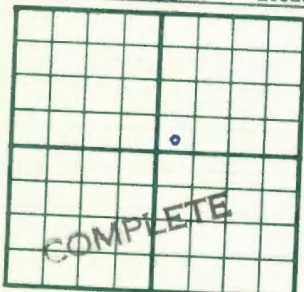

150 Ft. From **S** Line **NE**
 150 Ft. From **W** Line **Quarter**

1st. Report


Completion **JAN 1 2 1955**

Remarks **Hugoton Pool**
Noble Drlg. - Contr.

Spudding Date **12-5-54**Drlg. Data **Gas well** **TD 2622**8" @ 920 **Her. 2544** **Kri. 2572**Win. 2607 **TD 2622** 5" @ 2607CO to 2622 **Jet-frac** 1,640,000 cfg60 gawph **SP 2590** 12/ 2546-48192/ 2550-82 **jet-frac** **SP 2622**2,009,000 cfg **Comp. 4,169,000 cfg** 315#

FABEN GILSTRAP

County **Finney** State **Kansas**
 Sec. **2** (Blk. **25** (Sur. **32W** Map No.
 Operator **Stanolind**
 Well No. **1** Farm **Hicks Gas Unit "B"**
 Elev. Location **SW SW NE**

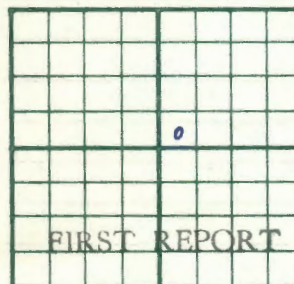150 Ft. From **S** Line **NE**150 Ft. From **W** Line **Quarter**1st. Report **DEC 1 1954**

Completion

Remarks

Noble Drlg. - Contr.

Spudding Date

Drlg. Data **Hugoton Pool****Location**

FABEN GILSTRAP