


KANSAS

Finney County

Sec. 3 Twp. 25 R. 32W

Well No. #1 Hicks Farm \_\_\_\_\_  
Stanolind Company \_\_\_\_\_

Hugoton  
2640 Ft. from N. Line  
\_\_\_\_\_ Ft. from S. Line  
2640 Ft. from E. Line  
\_\_\_\_\_ Ft. from W. Line

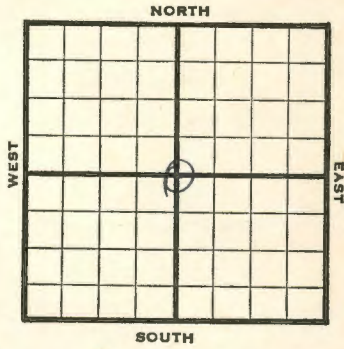

C Sec.

1946 2840 REPORT

- 7/24 Location
- 7/30 867 rancsg.
- 8/6 8" @ 868  
Drlg 2559
- 8/13 Drlg 2629'
- 8/20 TD 2666'  
5" @ 2603  
5500 acid
- 8/27 102 shots  
2542-59 CO
- 9/5 " "
- 9/10 " "
- 9/18 5" @ 2603'  
Perf  
TD 2666'  
6000 Acid  
1,236,000 Gas  
RPR 388#


COMPLETED

Finney County

Section 3 Township 25 Range 32W

Well No. #1 Hicks

Company Stanolind

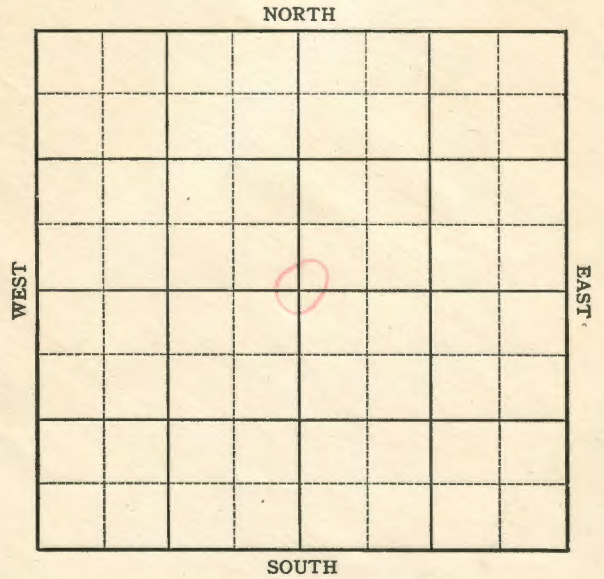

KANSAS

Kansas Pool Name Hugoton Pool

Map No. \_\_\_\_\_ Sec. 3 Twp. 25 R. 32W

Well No. 1 Hicks

Stanolind Company

COMPLETED Contractor

C Sec. E1. 2540


SECTION PLAT

2640 Ft. from N. Line

\_\_\_\_\_ Ft. from S. Line

2640 Ft. from E. Line

\_\_\_\_\_ Ft. from W. Line

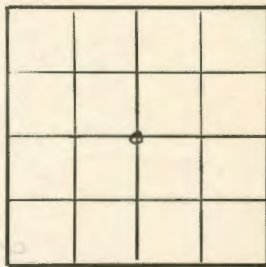

Finney County

Location \_\_\_\_\_

Rig up \_\_\_\_\_

Drilling and Remarks:

5 22603

Ref.

6000 acid

1,286,000 Gas

388 R.P.

RECORD

Cased \_\_\_\_\_ in. \_\_\_\_\_ ft.

Sand \_\_\_\_\_

Gas \_\_\_\_\_

Oil \_\_\_\_\_

Total Depth 2666

PRODUCTION

1st 24 hrs. Nat. \_\_\_\_\_

1st 24 hrs. after shot \_\_\_\_\_

Gas \_\_\_\_\_ Cu. Ft.

Dry Hole \_\_\_\_\_

Abandoned \_\_\_\_\_

Date \_\_\_\_\_

SEP 1 8 1946 19

S. J. LEWIS Scout

KANSAS

Kansas Pool Name Hugoton

Map No. \_\_\_\_\_ Sec. 3 Twp. 25 R. 32W

Well No. 1 Hicks

Stanolind Company

FIRST REPORT Contractor

C Sec. \_\_\_\_\_


SECTION PLAT

2640 Ft. from N. Line

\_\_\_\_\_ Ft. from S. Line

2640 Ft. from E. Line

\_\_\_\_\_ Ft. from W. Line

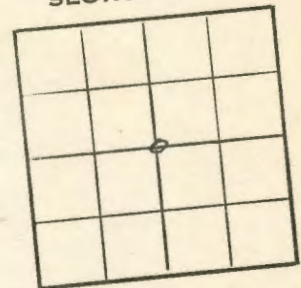

Finney County

Location X

Rig up \_\_\_\_\_

Drilling and Remarks:

RECORD

Cased \_\_\_\_\_ in. \_\_\_\_\_ ft.

Sand \_\_\_\_\_

Gas \_\_\_\_\_

Oil \_\_\_\_\_

Total Depth \_\_\_\_\_

PRODUCTION

1st 24 hrs. Nat. \_\_\_\_\_

1st 24 hrs. after shot \_\_\_\_\_

Gas \_\_\_\_\_ Cu. Ft.

Dry Hole \_\_\_\_\_

Abandoned \_\_\_\_\_

Date \_\_\_\_\_

JUL 2 4 1946 19

S. J. LEWIS Scout