


KANSAS

Section 7 Township 25 Range 32W

Well No. #2 Burnside (B)

Company Magnolia

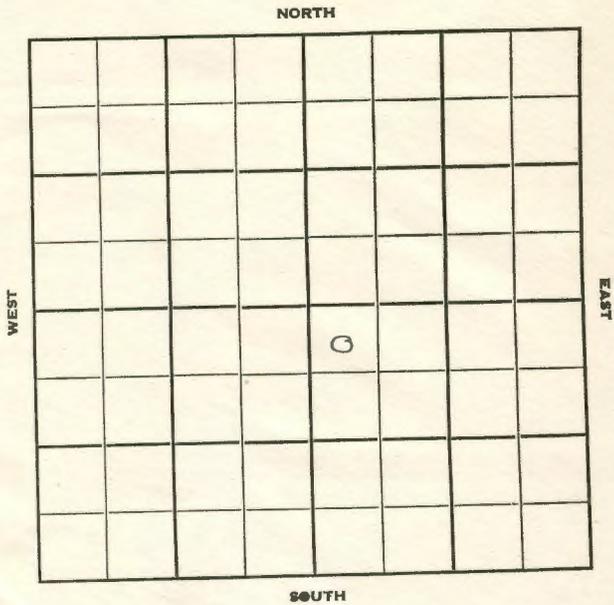

KANSAS

Sec. 7 Twp. 25 R. 32W

Well No. #2 Burnside (B) Farm

Magnolia Company

Contractor


100 Ft. from N. Line

_____ Ft. from S. Line

_____ Ft. from E. Line

100 Ft. from W. Line

NW NW SE

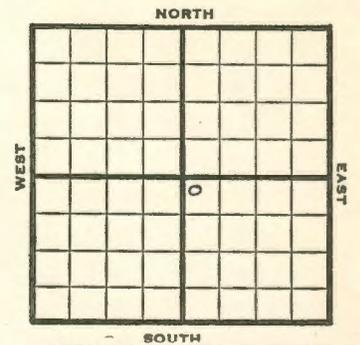

1952

REPORT

4/2 Spud ~~3 28 52~~
Orig. 300'

4/9 "

5/13 Abandoned location

ABANDONED


County Finney State Kansas
Sec. 7 (Blk. 25 (Sur. 32W Map No.
Operator Magnolia Pet.
Well No. 2 Farm Burnside "B"

Elev. _____ Location NW NW SE
330 Ft. From N Line SE
330 Ft. From W Line Quarter

ABANDONED					

1st. Report _____
Completion MAY 14 1951
Remarks _____
Spudding Date _____

Drig. Data
Incorrect information. Abd. location

 

J. G. McGEHEE

County Finney State Kansas
Sec. 7 (Blk. 25 (Sur. 32W Map No.
Operator Magnolia
Well No. 2 Farm Burnside (B)

Elev. _____ Location NW NW SE
100 Ft. From N Line SE
100 Ft. From W Line Quarter

FIRST REPORT					

1st. Report APR 2 1952
Completion _____
Remarks _____
Spudding Date 3-28-52

Drig. Data
Drig. 300

J. G. McGEHEE