

FORM 252-B

Finney

KANSAS

Sec. 11 Twp. 25 R. 32WWell No. 3 Hicks FarmD. R. Lauck Company

Contractor

150 Ft. from N. Line


Ft. from S. Line

150

Ft. from E. Line

Ft. from W. Line

NE SW

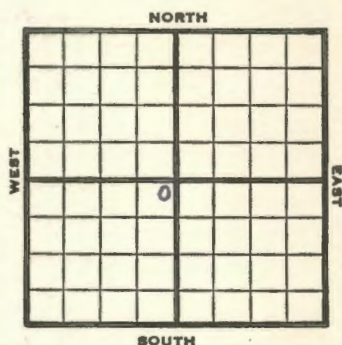

1953 Elev. 2837' REPORT


8/19 Location
 8/26 8" @ 285 w/250
 RTD 2596
 5" @ 2572
 9/2 C.O.
 9/9 DD 2616' A-frac. Plug 2581'
 90/2538-53 102/2561-78 Frac
 9/16 5000 A
 9/23 Spud 8-14-53 Oil well TD 2616
 8" @ 285 Her. 2542 Kri. 2559
 Win. 2600 TD 2616 5" @ 2572
 A-frac. SP 2581 90/2538-53
 102/2561-78 Frac 5000 A
 Comp. 3,200,000 gas 406#

COMPLETED

Finney

KANSAS

FORM 51

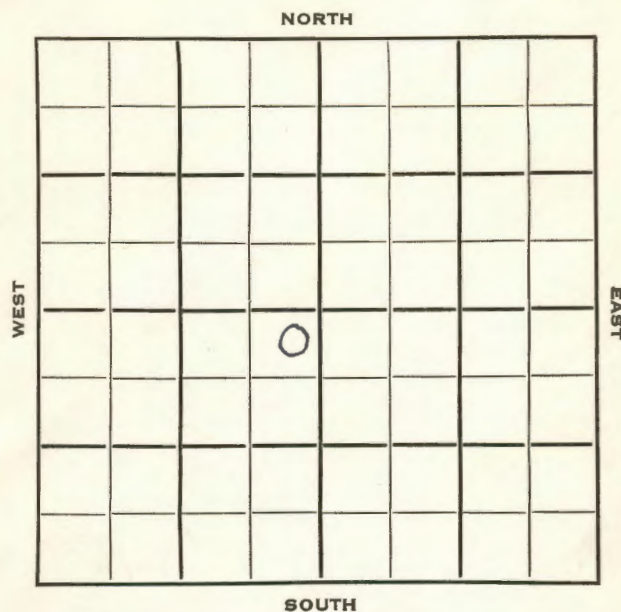Section 11 Township 25 Range 32WWell No. #3 HicksCompany D.R. Lauck

County	Finney	State	Kansas
Sec.	11 (Blk. Twp.)	25 (Sur. Rge.)	32W Map No.
Operator	D. R. Lauck		
Well No.	3	Farm	Hicks
Elev.	Location NE SW		

FIRST REPORT

0

150	Ft. From	Line	SW
150	Ft. From	Line	Quarter

1st. Report AUG 19 1953

Completion

Remarks

Spudding Date

Drig. Data

Location

J. G. McGEHEE

County	Finney		State	Kansas	
Sec.	11	(Blk. Twp.)	25	(Sur. Rge.)	32W Map No.
Operator	D. R. Lauck				
Well No.	3	Farm	Hicks		

COMPLETE

150 Ft. From N Line SW

150 Ft. From E Line Quarter

1st. Report

Completion SEP 23 1953

Remarks

Spudding Date 8-14-53

Drilg. Data Oil well TD 2616

8" @ 285 Her. 2542 Kri. 2559

Win. 2600 TD 2616 5" @ 2572 a-frac

SP 2581 90/ 2538-53 102/ 2561-78

frac 5000 A Comp. 3,200,000 gas 406#

J. G. McGEHEE