

FORM 282-B

Finney **KANSAS**

Sec. 13 Twp. 25 R. 32W ✓

Well No. 4 Hicks Farm

D. R. Lauck Company

Contractor


150 Ft. from N. Line

Ft. from S. Line

150 Ft. from E. Line

Ft. from W. Line

NE SW

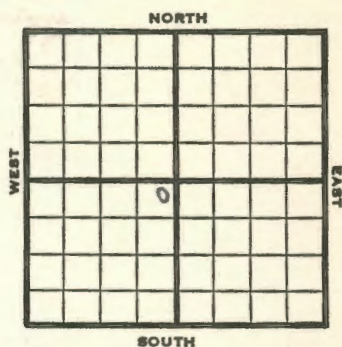

1953 **Elev. 2852'** REPORT

8/19 Location

8/26 8" @ 331 w/250 sks

9/2 RTD 2625'

5" @ 2625'

9/9 NR

9/16 **Her 2560, Kr. 2585, Win 2616**

DD 2636 TD frac 102/ 2562-79

78/ 2587-2600 frac.

9/23 Spud 8-20-53 Gas well TD 2636

8" @ 331 **Her. 2560'** **Kri. 2585**

Win. 2616 TD 2636 5" @ 2625

frac. 102/2462-79 78/2587-2600

frac.

Comp. 9,991,000 gas. 405#

COMPLETED

FORM 51

Finney **KANSAS**

Section 13 Township 25 Range 32W

Well No. #4 Hicks

Company D.R. Lauck

