

FORM 282-B

Finney

KANSAS ✓

Sec. 14 Twp. 25 R. 32W

Well No. #1 Hicks Farm

D. R. Lauck Company

Contractor

Hugoton Pool


150 Ft. from N. Line

Ft. from S. Line

150 Ft. from E. Line

Ft. from W. Line

NE SW

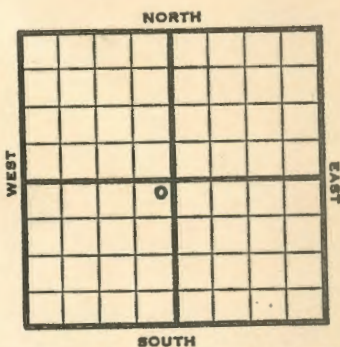

1953 Elev. 2872' REPORT

- 7/1 Spud 6-28-53
8" @ 400, WOC
- 7/8 "
- 7/22 RTD 2626
5" @ 2621'
Her Kr. 2568, Win 2590
DD 2646
TD
dol-frac
PB 2611 66/ 2597-2608 78/ 2571-84
dol-frac.
- 7/29 Spud 6-28-53
Gas Well
TD 2646
8" @ 400
TD 2626
5" @ 2621
Her 2568, Win 2590
DD 2646, dol-frac
PB 2611, 66/2597-2608, 78/2571-84,
dol-frac
CO to 2626
Comp. 6 1/3 mcfgpd

COMPLETED

FORM 51 25M 8-50 WESTERN

Finney

KANSAS

Section 14 Township 25 Range 32W

Well No. #1 Hicks

Company D. R. Lauck

