

Finney KANSAS

SEC. 24 TWP. 25 R. 32W ✓

WELL NO. #1 "B"
#2 Hicks "A"

COMPANY FARM

Petroleum, Inc.

CONTRACTOR


Hugoton Pool

_____ Ft. from N. Line

330 _____ Ft. from S. Line

330 _____ Ft. from E. Line

_____ Ft. from W. Line

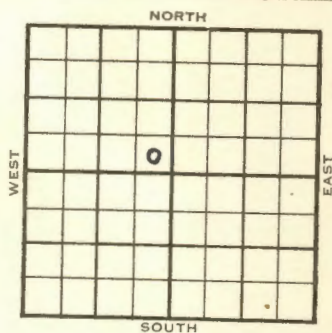

SE SE NW
Magnolia Farmout

1953 ELEVATION 2887' REPORT

12/2 MIR

12/9 8" @ 428'
RTD 2680'
Her 2610'
5" @ 2674'

1954
1/27 Spud 12-1-53
Gas Well
TD 2688'
8" @ 428'
Her 2610', Kri 2644, Win 2672'
TD 2680
5" @ 2674
CO to 2668, DD 2688, 500A, 6000A
65/2643-56, 110/2615-37, 100 mud-acid
frac 3000A, frac
Comp. 6,250,000 gas, 411#

COMPLETED


FORM 51

Finney KANSAS

Section 24 Township 25 Range 32 W

Well No. #1 Hicks "A" "B"

Company Petroleum Inc.

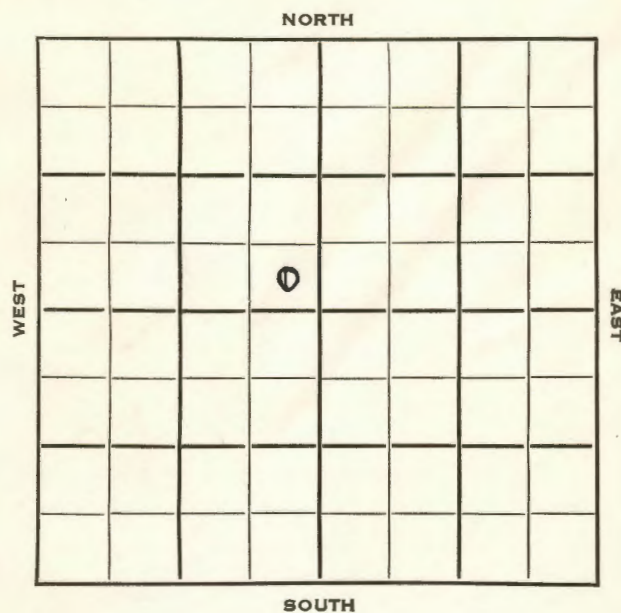

Map No. _____ Sec. 24 Twp. 25 R. 32W

Well No. 1 Hicks "B"

Petroleum Inc.

Company

CORRECTION

Contractor

SE SE NW

SECTION PLAT

_____ Ft. from N. Line

330

Ft. from S. Line

330

Ft. from E. Line

_____ Ft. from W. Line

Finney County

Location _____

Rig up _____

Drilling and Remarks:

Reported

#2 Hicks "A"

RECORD

Cased _____ in, _____ ft.

Sand _____

Gas _____

Oil _____

Total Depth _____

PRODUCTION

1st 24 hrs. Nat. _____

1st 24 hrs. after shot _____

Gas _____ Cu. Ft.

Dry Hole _____

Abandoned _____

Date

DEC 9 1953

19

J. G. McGEHEE

Scout