

Finney KANSAS

Sec. 19 Twp. 25 R. 32 W

Well No. # 1 Cowgill Farm

Champlin Ref. Company

Contractor


Ft. from N. Line

330 Ft. from S. Line

330 Ft. from E. Line

Ft. from W. Line

SE SE NW

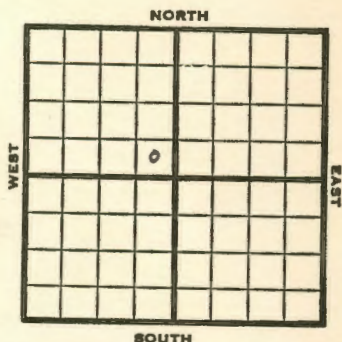

1951 Elev. 2901' REPORT

2/21 Location


5/29 Spud 3-10-51
Gas Well TD 2740
10" @ 433 Her. 2537
Krider 2557 Win. 2625
Tow 2687 Ft. Riley 2730
TD 2740 7" @ 2738
66/2537-54 102/2687-2704
48/2674-82 78/2625-38
30/2614-19 17,000 A
Comp. 8,861,000 gas

COMPLETED

Section 19 Township 25 Range 32W Finney KANSAS

Well No. #1 Cowgill

Company Champlin Ref.

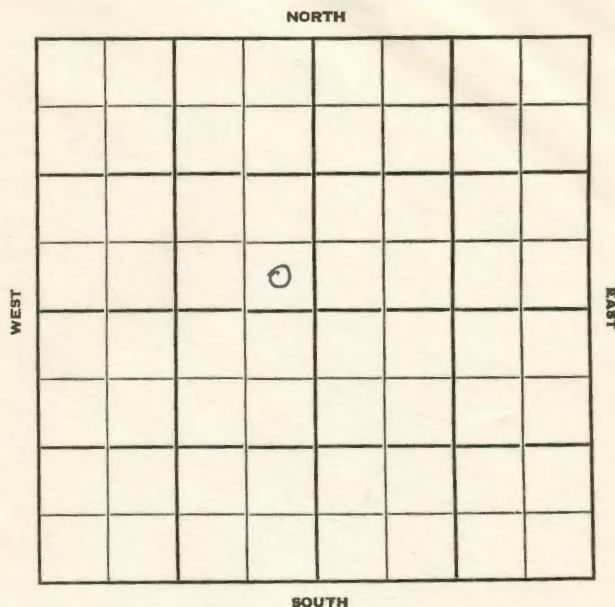

County Finney State Kansas
 Sec. 19 (Blk. 25 (Sur. 32W Map No.
 Operator Champlin Ref.
 Well No. 1 Farm Cowgill
 Elev. _____ Location SE SE NW
 330 Ft. From S Line NW
 330 Ft. From E Line Quarter
 1st. Report FEB 21 1951
 Completion _____
 Remarks _____
 Spudding Date _____

Drig. Data _____
 Location _____

FIRST REPORT

J. E. TYRA

County Finney State Kansas
 Sec. 19 (Blk. 25 (Sur. 32W Map No.
 Operator Champlin Ref.
 Well No. 1 Farm Cowgill
 Elev. 2901 Location SE SE NW
 330 Ft. From S Line NW
 330 Ft. From E Line Quarter
 1st. Report _____
 Completion MAY 29 1951
 Remarks _____
 Spudding Date 3-10-51

Drig. Data Gas well TD 2740
10" @ 433 Her. 2537 Krider 2557
Win. 2625 Tow. 2687 Ft. Riley 2730
TD 2740 7" @ 2738 66/ 2537-54
102/ 2687-2704 48/ 2674-82 78/ 2625-38
30/ 2614-19 17000 A
Comp. 8,861,000 gas

COMPLETE

J. E. TYRA