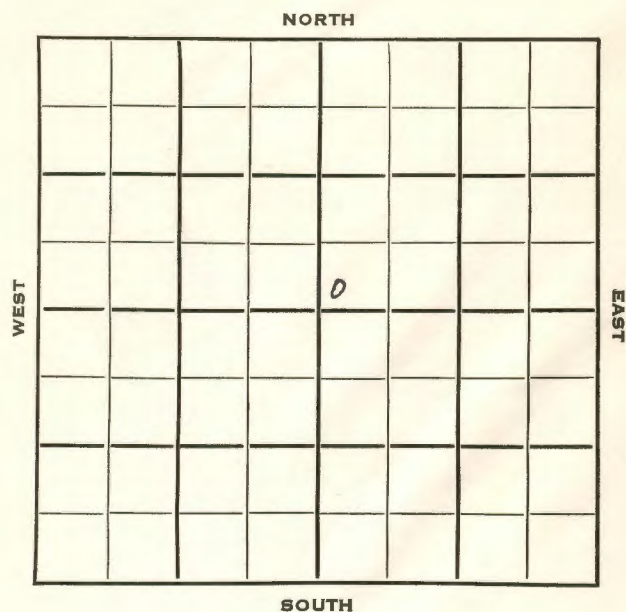


FORM 51

Finney

KANSAS

Section 22 Township 25 Range 32WWell No. #1 Hicks Gas UnitCompany Stanolind

Finney

KANSAS

SEC. 22 TWP. 25 R. 32W ✓WELL NO. #1 Hicks Gas Unit FARMCOMPANY Stanolind

CONTRACTOR

Hugoton Pool


_____ Ft. from N. Line

150 _____ Ft. from S. Line

_____ Ft. from E. Line

150 _____ Ft. from W. Line

SW SW NE

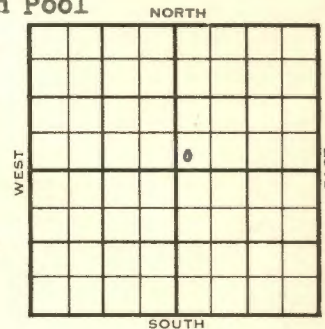

	ELEVATION	REPORT
1954	2866'	
2/17	Location	
2/24	Drlg 800'	
3/3	8" @ 966' w/500 sks	
	RTD 2628'	
	Schl	
	5" @ 2602'	
	Her. Kr. 2541', Win 2602'	
3/10	CO 2628'	
	2500 A	
	/ 2547-66 60/ 2571-81 3000 A	
3/24	Spud 2-21-54	
	Gas Well	
	TD 2628'	
	8" @ 966'	
	Her. Kri 2541', Win 2602',	
	TD 2628'	
	5" @ 2602'	
	CO to 2628'	
	2500 A perf 2547-66 60/ 2571-81	
	3000 A 1,161,000 gas 6 gswph	
	7000 A	
	1,261,000 gas 10 gswph 4000 A	
	Comp 4,169,000 gas 342#	
	COMPLETED	

County	Pinney	State	KANSAS
Sec.	22 (Blk.) (Twp.)	25 (Sur.) (Rge.)	32W Map No.
Operator	Stanolind		
Well No.	1	Farm	Hicks Gas Unit
Elev.	Location SW SW NE		

[illegible]

160	Ft. From	S	Line	NE
160	Ft. From	W	Line	Quarter
1st. Report	FEB 17 1954			
Completion				
Remarks				

Spudding Date _____

Drig. Data

Location

J. G. McGEHEE

County	Finney		State	Kansas	
Sec.	22	(Blk.) Twp.	25	(Sur.) Rge.	32W Map No.
Operator	Stanolind				
Well No.	1	Farm	Hicks Gas Unit		
Elev.	2866	Location	SW SW NE		

COMPLETE

150 Ft. From S Line NE

150 Ft. From W Line Quarter

1st. Report

Completion **MAR 24 1954**

Remarks Hugoton Pool

Spudding Date 2-21-54

Drlg. Data Gas well TD 2628

8" @ 966 Her.Kri. 2541 Win. 2602

TD 2628 5" @ 2602 CO to 2628 2500 A

perf/ 2547-66 60/ 2571-81 3000 A

1.161,000 gas 6 gswph 7000 A

1.261.000 gas 10 gswph 4000 A

Comp. 4,169,000 gas 342#

J. G. McGEHEE