

Finney KANSAS

Sec. 28 Twp. 25 R. 32 W

Well No. # 1 Spence Farm

Champlin Ref. Company

Contractor


330 Ft. from N. Line

Ft. from S. Line

330 Ft. from E. Line

Ft. from W. Line

NE NE SW

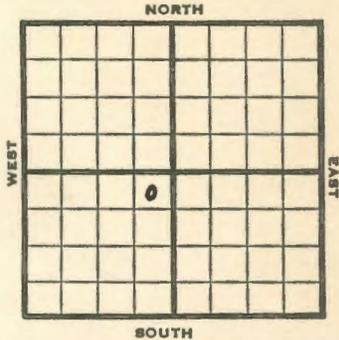

1953 Elev. 2864' REPORT

6/24 Location
7/1 10" @ 555 w/450
Drlg. 2040'

7/8 Hol 2490' Her 2510 Kr 2586
Win 2612 RTD 2654 7" @ 2654 XED
CO 2642 162/2612-39 4000 A

7/22 Plug 2602 222/ 2561-98 4000 A
CO 2642 14000 A

7/29 NR
8/26 "
10/7 Spud 6-20-53
Gas Well
TD 2654'
10" @ 555'
Hol. 2490, Her. 2510, Kri 2586, Win
2612'
TD 2654'
7" @ 2654'
CO to 2642 162/ 2612-39 4000 A
SP 2602 222/ 2561-98 4000 A
CO to 2642
14000 A 56/ 2598-2612 CO to 2641
112/ 2612-40 2000 frac 32/ 2588-96
64/ 2560-70 4000 frac CO to 2641
Comp 5 1/2 mcfgpd

CHAMPLIN REF.


Finney KANSAS

Section 28 Township 25 Range 32 W

Well No. # 1 Spence

Company Champlin Refg.

NORTH

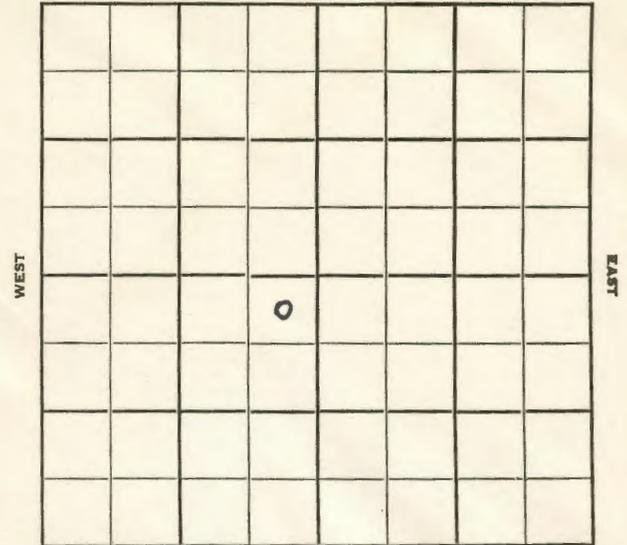

SOUTH

