

FORM 282-B Finney

KANSAS

Sec. 30 Twp. 25 R. 32WWell No. #1 Smith Farm

W.E. Bakke

Company

Contractor

100

Ft. from N. Line


Ft. from S. Line

Ft. from E. Line

100

Ft. from W. Line

NW NW SE

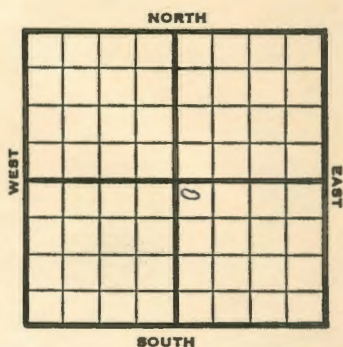

1952 Elev. 2895' REPORT

11/18 Location

11/27 "

12/4 "

12/11 8" @ 501 Her 2552 RTD 2560 5" @ 2553
DD Winfield 2613 TD 2647 17,000A12/23 Spud 11-22-52 Gas well TD 2647'
8" @ 501 Her. 2552' Win. 2613'
TD 2647' 17,000 A
Comp. 9 MCFGPD

COMPLETED

FORM 51 25M 3-49 PETROL

Finney

KANSAS

Section 30 Township 25 Range 32 WWell No. # 1 SmithCompany W. E. Bakke