

Finney

KANSAS

Sec. 32 Twp. 25 R. 32W

Well No. #1 Nuffer Farm

Northern Pump Company

Contractor

Hugoton


330' Ft. from N. Line

Ft. from S. Line

Ft. from E. Line

330' Ft. from W. Line

NW NW SE

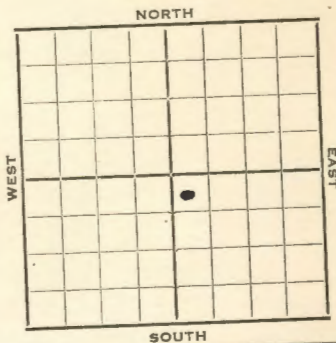

1952

Elev. 2875

REPORT

2/13

Spud 2-9-52
10" @ 518

WOC

2/20

NR

3/5

CO to 2694 1000 A PB 2684

3/12

Her 2562 Winfield 2624

Up Ft 2684 120/2562-98

72/2624-42 1000 A PB 2610 sq off

3/19

CO to 2601 121/ 2562-98 NS
6000A

3/25

4500 A Swabbing

4/1

13,000 A Gas Well TD 2700

4/9

Spud 2-9-52 10" @ 518 7" @ 2684

Her. 2562 Win 2624 Ft. Riley 2684

120/2562-98 72/2624-42 PB 2610

CO to 2601 121/2562-42 PB 2610

CO to 2601 121/2562-98 13000 A

Comp. 5,720,000 gas.


COMPLETED

KANSAS

Section 32 Township 25 Range 32W

Well No. #1 Nuffer

Company Northern Pump

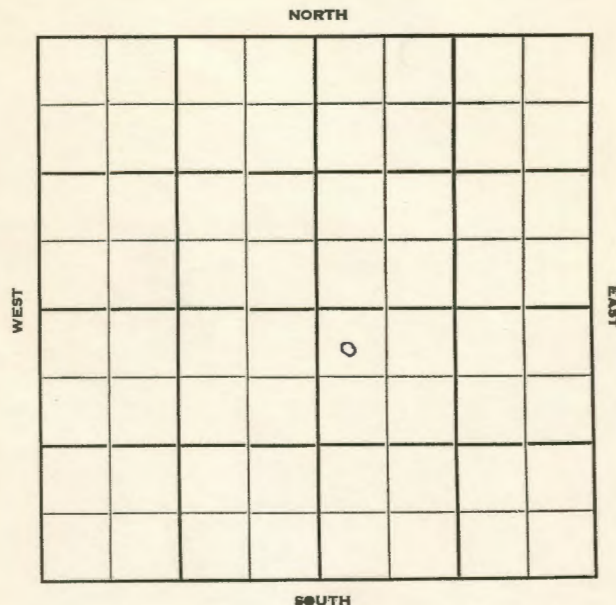

County Finney State Kansas

Sec. 32 (Bk. 2 5) (Sur. 32W) Map No.

Operator Northern Ordnance

Well No. 1 Farm Muffer

Elev. 2875 Location NW NW SE

330 Ft. From N Line SE		330 Ft. From W Line Quarter	
Completion		APR 9 1952	
Remarks		Hugton Pool	
Spudding Date		2-9-52	

Drig. Data Gas well TD 2700

10" @ 518 7" @ 2684 TD 2700

Her. 2562 Win. 2624 Ft. Riley 2684

120/ 2562-98 72/ 2624-42 PB 2610

CO to 2601 121/ 2562-98 13000 A

Comp. 5,720,000 gas

J. G. McGEHEE

County **Pinney** State **Kansas**
 Sec. **32** (Blk.) **25** (Sur.) **32W** Map No.
 Elev. **1** Farm **Ruffer**
 Operator **Northern Pump**
 Well No. **1** Location **NW NW SE**
 330 Ft. From **N** Line **SE**
 330 Ft. From **W** Line **Quarter**
 Ist. Report **FEB 13 1952**
 Completion
 Remarks
 Spudding Date **2-9-52**
 Drilg. Data **Hugoton**
 10" @ 518 W.C.

J. G. McGEHEE