


FORM 51

Finney KANSAS

Section 33 Township 25 Range 32W

Well No. 1 Staley

Company Northern Pump

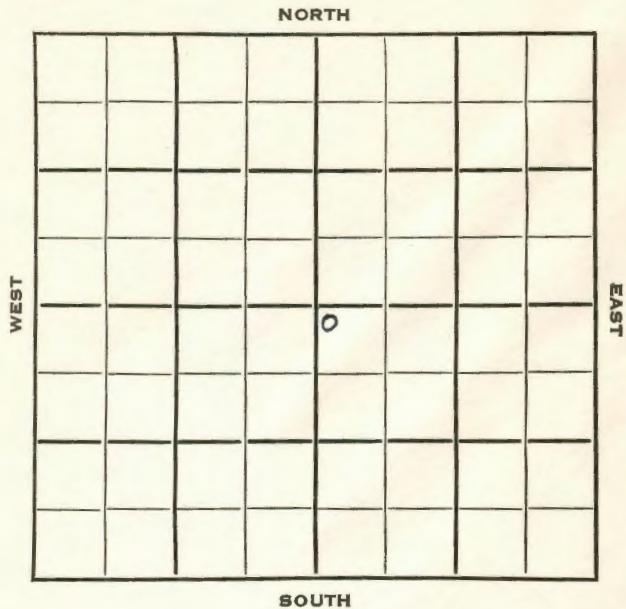

Finney KANSAS

SEC. <u>33</u>	TWP. <u>25</u>	R. <u>32 W</u> ✓
----------------	----------------	------------------

WELL NO. # 1 Staley FARM

COMPANY Northern Pump

CONTRACTOR

Hugoton Pool

100 Ft. from N. Line

_____ Ft. from S. Line

_____ Ft. from E. Line

100 Ft. from W. Line

NW NW SE

	ELEVATION	REPORT
1953	2867'	
12/16	Location	
1954 1/6	10" @ 538' Drig 1905'	
2/17	Spud 1-1-53 Gas well TD 2614 10" @ 538 Her. 2586 Kri. 2610 Win. 2636 TD 2639' 7" @ 2638 CO to 2560 CO to 2624 DD 2614 eol-frac PB 2610 42/2586-2600 frac CO to 2614 20/2614-24 frac. Comp. 5 1/2 MCFG 421#	
	COMPLETED	

