

Finney

KANSAS

SEC.	TWP.	R.
27	25	32W ✓

WELL NO.

#1 Nusser Gas Unit "A"

FARM

COMPANY

Stanolind

CONTRACTOR

Hugoton Pool

NORTH

Ft. from N. Line

150


Ft. from S. Line

Ft. from E. Line

150

Ft. from W. Line

SW SW NE

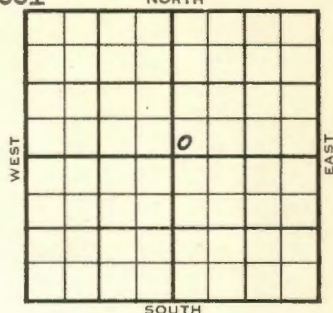

1954

ELEVATION

2880'

REPORT

2/3

Location

2/17

8" @ 960'

2/24

RTD 2642' Log.

Her. Kr. 2568', Win 2627',

5" @ 2677'

Drlg.

3/3

DD 2652'

TD

2500 A 72/ 2580-92 12/ 2594-96

12/2599-2601 24/ 2609-13 7000 A

3/24

Spud 2-13-54

Gas Well

TD 2652'

8" @ 960'

Her. Kr. 2568', Win 2627',

TD 2642'

5" @ 2627'

DD 2652' 2500 A 72/ 2580-92 12/

2594-96 12/ 2599-2601

24/ 2609-13 9000 A

Comp 1,917,000 gas 340#

COMPLETED

Finney

FORM 51


KANSAS

Section 27 Township 25 Range 32W

Well No. #1 Nusser Gas Unit "A"

Company Stanolind

NORTH

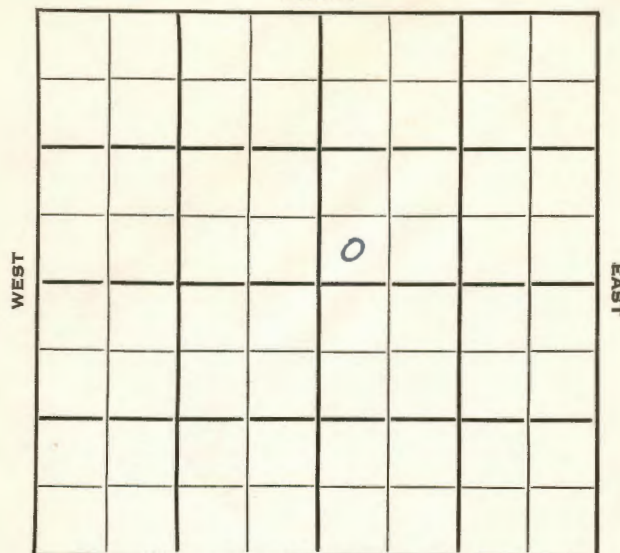

SOUTH

