


Section 15 Township 25 Range 32W

Well No. #2 Hicks

Company D. R. Lauck

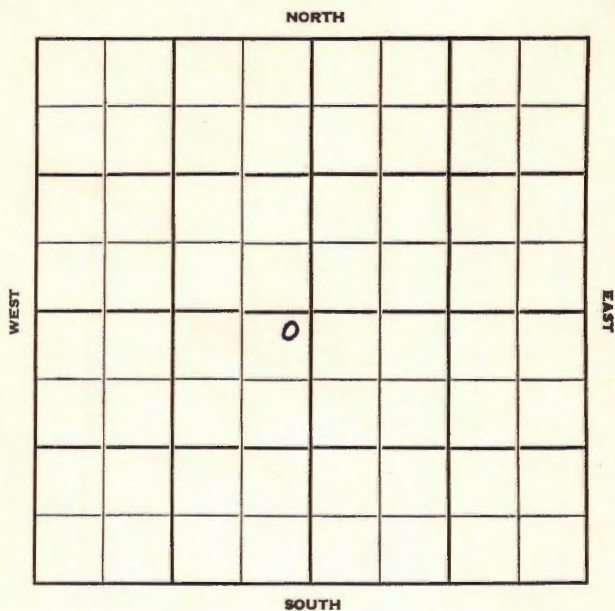

Finney  
25

**KANSAS** ✓

Sec. 15 Twp. \_\_\_\_\_ R. 32W

Well No. #2 Hicks Farm \_\_\_\_\_

D. R. Lauck Company \_\_\_\_\_

Contractor \_\_\_\_\_

**Hugoton Pool**


150 Ft. from N. Line

\_\_\_\_\_ Ft. from S. Line

150 Ft. from E. Line

\_\_\_\_\_ Ft. from W. Line

NE SW

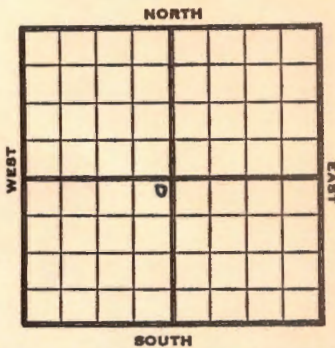

1953

**Elev. 2884'**

REPORT

7/1

Location

7/8

"

7/22

8" @ 400'

RTD 2619

5" @ 2613'

**Her 2560, Kr. 2580, Win 2612.**

7/29

NR

8/5

DD 2634 frac PB 2600 84/ 2562-76

96/ 2582-98 dol-frac CO 2634'

8/12

Gas Well

TD 2634

8" @ 400

**Her 2560, Kri 2580, Win 2612**

TD 2619

5" @ 2613

DD 2634 frac

PB 2600, 84/2562-76, 96/2582-98

Dol-frac

CO to 2634

Comp. 8 1/2 mcfgpd 405#

**COMPLETED**

County Finney State Kansas

Sec. 15 (Blk. Twp.) 25 (Sur. Rge.) 32W Map No.

Operator D. R. Lauck

Well No. 2 Farm Hicks

Elev. 2884 Location NE SW



150 Ft. From N Line SW

150 Ft. From E Line Quarter

1st. Report

Completion AUG 12 1953

Remarks Hugoton Pool

Spudding Date

Drlg. Data Gas well TD 2634

8" @ 400 Her. 2560 Kri. 2580

Win. 2612 TD 2619 5" @ 2613 DD 2634

frac PB 2600 84/ 2562-76 96/ 2582-98

dol-frac CO to 2634

Comp. 8½ mcfgpd 405#

