

**STATE CORPORATION COMMISSION OF KANSAS
OIL & GAS CONSERVATION DIVISION
RECOMPLETION FORM
ACO-2 AMENDMENT TO WELL HISTORY**

API NO. 15- 055-20,906 **CONFIDENTIAL**
County Finney

Operator: License # 4253
Name: Plains Petroleum Operating Co.
Address: P.O. Box 15278
City/State/Zip: Lakewood, CO 80215

NE SW SW Sec. 35 Twp. 25S Rge. 32 East West
1250 Ft. North from Southeast Corner of Section
4030 Ft. West from Southeast Corner of Section
(NOTE: Locate well in section plat below.)

Purchaser: KN Energy, Inc.


Lease Name Kirkpatrick Well # 1-I
Field Name Hugoton

Operator Contact Person: Paul R. Brandt
Phone: (303) 969-9325

Producing Formation Chase

Elevation: Ground 2838' KB 2849'

Designate Type of Original Completion
 New Well Re-Entry Workover

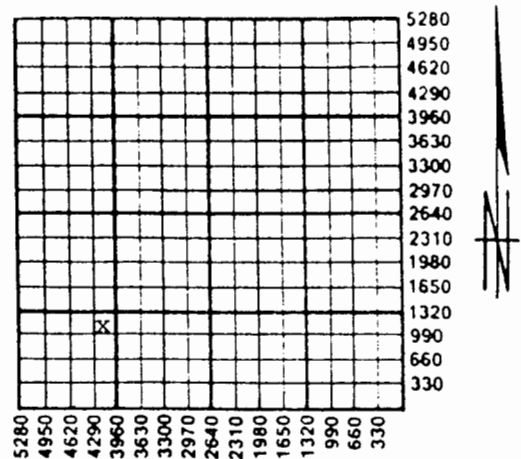

Date of Original Completion _____

Name of Original Operator Plains Petroleum Oper. Co.

Original Well Name Kirkpatrick 1-I

Date of Recompletion: 5-15-90 11-12-90
Commenced Completed

Re-entry Workover

Designate Type of Recompletion/Workover:
 Oil SWD Temp. Abd.
 Gas Inj Delayed Comp.
 Dry Other (Core, Water Supply, etc.)
 Deepening Re-perforation
 Plug Back PBTD
 Conversion to Injection/Disposal

K.C.C. OFFICE USE ONLY

F Letter of Confidentiality Attached
C Wireline Log Received
C Drillers Timelog Received

Distribution

KCC SWD/Rep NGPA
 KGS Plug Other (Specify) **IS**

Is recompleted production:
 Commingled Docket No. _____
 Dual Completion Docket No. _____
 Other (Disposal or Injection?) Docket No. _____

INSTRUCTIONS: This form shall be completed in triplicate and filed with the Kansas Corporation Commission, 200 Colorado Derby Building, Wichita, Kansas 67202, within 120 days of the recompletion of any well. Rules 82-3-107 and 82-3-141 apply. Information on side two of this form will be held confidential for a period of 12 months if requested in writing and submitted with the form. See rule 82-3-107 for confidentiality in excess of 12 months. One copy of any additional wireline logs and driller's time logs (not previously submitted) shall be attached with this form. Submit ACO-4 or ACO-5 prior to or with this form for approval of commingling or dual completions. Submit CP-111 with all plugged wells. Submit CP-111 with all temporarily abandoned wells. NOTE: Conversion of wells to either disposal or injection must receive approval before use; submit form U-1.

All requirements of the statutes, rules and regulations promulgated to regulate the oil and gas industry have been fully complied with and the statements herein are complete and correct to the best of my knowledge.

Signature Paul R Brandt Title District Engineer Date 2-1-91

Subscribed and sworn to before me this 01 day of February 19 91

Notary Public: Dana Lynn Bucknham DANA LYNN BUCKNHAM
NOTARY PUBLIC, Commission Expires 26 October 1994

FEB 4 1991
CONSERVATION DIVISION
Wichita Kansas