

KANSAS

Finney

Section 15 Township 25 Range 33-W

Well No. #1 Tate "E"

Company Cities Service
Hugoton Pool

NORTH

WEST

EAST

			0				

SOUTH

KANSAS

Finney

Sec. 15 Twp. 25 R. 33-W

Well No. #1 Tate "E" Farm

Cities Service

Company

Hugoton Pool

Contractor

200

Ft. from N. Line


Ft. from S. Line

200

Ft. from E. Line

Ft. from W. Line

NE SW

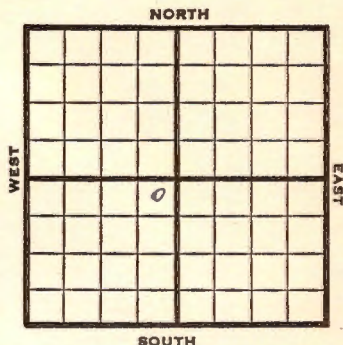

1949

Elev 2911'

REPORT

11/23
12/7

Location
TD 2705'

from

11/29

Late information added *from* Drilling Report
410 shots 2536-2682

12/7

29000 acid
9000 acid

12/14

"

12/21

TD 2705'
5" @ 2704'
Perf 38000 acid
7,730,000 Gas
412# R Pr.
Comp

COMPLETED

Kansas

Map No. _____ Sec. 15 Twp. 25 R. 33W

Well No. 1 Tate "E"

Cities Service

Company

COMPLETE

Contractor

NE SW


E 12911
SECTION PLAT

200 Ft. from N. Line

Ft. from S. Line

200 Ft. from E. Line

Ft. from W. Line

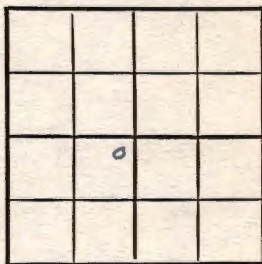

Finney County

Location _____

Rig up _____

Drilling and Remarks:

5" C 270 x

Pay.

35000.00

7,730,000 lbs

4/24 R 12

RECORD

Cased _____ in., _____ ft.

Sand _____

Gas _____

Oil _____

Total Depth 2205

PRODUCTION

1st 24 hrs. Nat. _____

1st 24 hrs. after shot _____

Gas _____ Cu. Ft.

Dry Hole _____

Abandoned _____

Date

DEC 21 1949 19

S. J. LEWIS

Scout

Map No. _____ Sec. 15 Twp. 25 R. 33W

Well No. 1 Tate "E"

Cities Service Company

CORRECTION Contractor

NE SW


SECTION PLAT

200 Ft. from N. Line

_____ Ft. from S. Line

200 Ft. from E. Line

_____ Ft. from W. Line

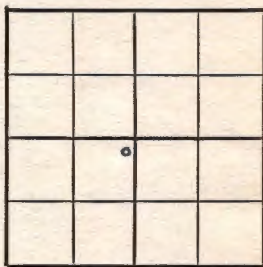

Finney County

Location _____

Rig up _____

Drilling and Remarks:

Reported in
Kearny County

We show only
this well in

This section

RECORD

Cased _____ in., _____ ft.

Sand _____

Gas _____

Oil _____

Total Depth _____

PRODUCTION

1st 24 hrs. Nat. _____

1st 24 hrs. after shot _____

Gas _____ Cu. Ft.

Dry Hole _____

Abandoned _____

Date

NOV 23 1940 19

S. J. LEWIS Scout

~~Form~~ 26 200 Bks. 6-49 Petrol
Kansas

Hugoton Pool

Map No. _____ Sec. 15 Twp. 25 R. 33W

Well No. 1 Tate "E"

Cities Service Company

Corbett & Barber Contractor

NE SW

FIRST REPORT
SECTION PLAT

200 Ft. from N. Line

_____ Ft. from S. Line

200 Ft. from E. Line

_____ Ft. from W. Line

Kearny County

Location X

Rig up

Drilling and Remarks:

RECORD

Cased _____ in., _____ ft.

Sand _____

Gas _____

Oil _____

Total Depth _____

PRODUCTION

1st 24 hrs. Nat. _____

1st 24 hrs. after shot _____

Gas _____ Cu. Ft.

Dry Hole _____

Abandoned _____

Date

NOV 16 1949

19

S. J. LEWIS

Scout

Map No. _____ Sec. 15 Twp. 25 R. 33W

Well No. 1 Tate "E"

Cities Service Company

Corbett & Barber Contractor

NE SW


FIRST REPORT
SECTION PLAT

200 Ft. from N. Line

_____ Ft. from S. Line

200 Ft. from E. Line

_____ Ft. from W. Line

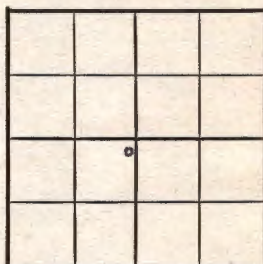

Finney County

Location _____

Rig up _____

Drilling and Remarks:

TD 2705

Sent in

Nov. 16, 1949

RECORD

Cased _____ in., _____ ft.

Sand _____

Gas _____

Oil _____

Total Depth _____

PRODUCTION

1st 24 hrs. Nat. _____

1st 24 hrs. after shot _____

Gas _____ Cu. Ft.

Dry Hole _____

Abandoned _____

Date

DEC 7 1949 19

S. J. LEWIS Scout