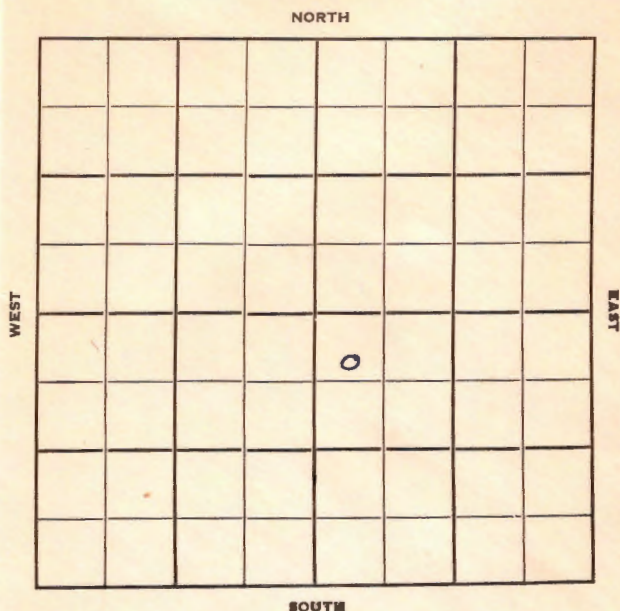


Section 24 Township 25 Range 33WWell No. #1 BrownCompany W. E. Bakke

Sec. 24 Twp. 25 R. 33W

Well No. #1 Brown Farm

W. E. Bakke Company

Contractor


 Ft. from N. Line

2505 Ft. from S. Line

2515 Ft. from E. Line

 Ft. from W. Line

NW NW SE

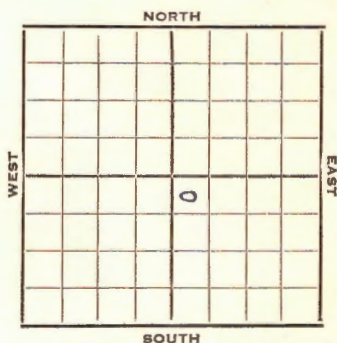

1952 **Elev. 2909'** REPORT

9/24	Spud 9-21-52 Drlg. 290'
10/1	8" @ 498' Her. 2561' TD 2570'
10/8	5" @ 2562' Kri 2601 TD 2717' 1500 A PB 2615 11000 A
10/15	1000A
10/22	No report
10/29	"
11/5	"
11/12	Spud 9-21-52 Gas Well TD 2717' 8" @ 498 Her 2561, Kri. 2601 TD 2717, 1500A PB 2615 11000A Comp. 2,720,000 gas

COMPLETED

J. G. McGEHEE

