


Section 25 Township 25 Range 33 WWell No. # 1 MurphyCompany W. E. Bakke

NORTH

WEST

EAST

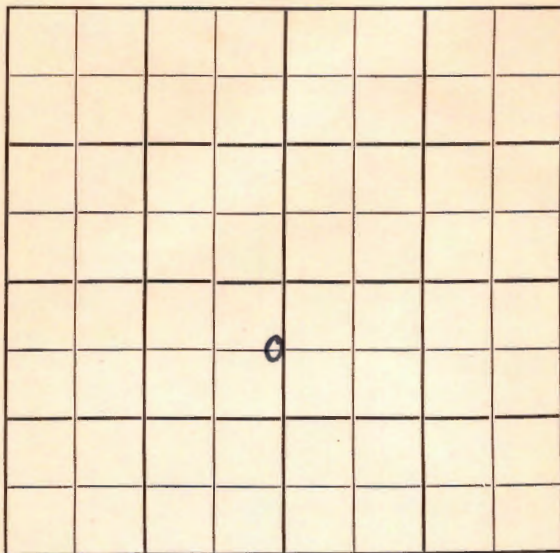

SOUTH

Sec. **25** Twp. **25** R. **33W**

Well No. **#1 Murphy** Farm
W. E. Bakke Company
Contractor


600 Ft. from N. Line

Ft. from S. Line

100 Ft. from E. Line

Ft. from W. Line

App. C E/2 NE SW

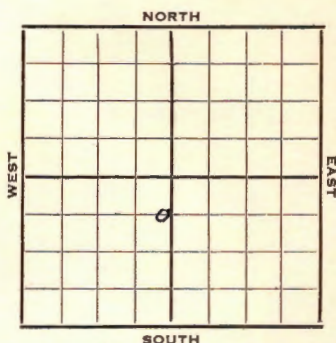

1952 **Elev. 2906'** **REPORT**

9/10 Spud 8-27-52
8" @ 495' RTD 2580'
5" @ 2573' WOC

9/17 DD 2617 1500 A TD 2726' 160' of
4½" liner
Her. 2574 Krider 2597
Winfield 2630 Up Ft. 2685

9/24 NR

10/1 Spud 8-27-52
Gas Well TD 2726'
8" @ 495' 5" @ 2573' TD 2617
1500 A DD 2726 Her. 2574
Kri. 2597 Win. 2630
Ft. Riley 2685 14000 A
Comp. 9,790,000 gas

COMPLETED

Finney

State **Kansas**

25

(Blk.)
(Twp.)

25

(Sur.)
(Rge.)

33W

Map No.

Operator

W. E. Balke

Well No.

2

Farm

Murday

Elev.

Location

APP C E/2 NE SW

600

Ft. From

Line

SW

100

Ft. From

E Line

Quarter

1st. Report

SEP 10 1952

Completion

Remarks

Spudding Date

8-27-52

Drig. Data

88

495

RTD 2580

5th

2573

WOC

J. G. McGEHEE

County Finney State Kansas
 Sec. 25 (Blk.) 25 (Sur.) 33W Map No.
 Operator W. E. Bakke
 Well No. 1 Farm Murphy
 Elev. 2906 Location C E L NE SW



600 Ft. From N Line SW
100 Ft. From E Line Quarter

1st. Report

Completion OCT 1 1952

Remarks

Spudding Date 8-27-52

Drig. Data Gas well TD 2726

8" @ 495 5" @ 2573 TD 2617 1500 A

DD 2726 Her. 2574 Kri. 2597

Win. 2630 Ft. Riley 2685 14000 A

Comp. 9,790,000 gas