

Finney

KANSAS

SECTION 30 TOWNSHIP 25 RANGE 33 W

WELL NO. #1 Jones "J"

COMPANY Northern Nat. Gas

NORTH

WEST				0			EAST

SOUTH

Finney

KANSAS

SEC. 30	TWP. 25	R. 33W
------------	------------	-----------

WELL NO. #1 Jones "J" FARM

COMPANY Northern Nat. Gas

CONTRACTOR Michaelis

Hugoton


_____ Ft. from N. Line

_____ Ft. from S. Line

_____ Ft. from E. Line

_____ Ft. from W. Line

NW NW SE

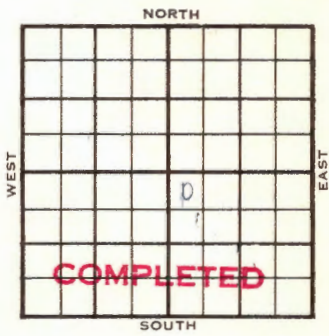

1956	ELEVATION	REPORT
------	-----------	--------

2-1	Loc.	
-----	------	--

17

FORM 513 REV SUNRAY

County Finney Elev. 2954 07
 2951 07
 Sec 30 Twp. 25 Rge. 33W
 Company Northern Nat. Gas
 Form Name Jones "JH" No. 1

TOPS	DEPTH	LOG	DATUM	Loc. in Sec.
Ana <u>Herc</u>		<u>2528</u>		<u>NW NW SE</u>
Top <u>L. Kri</u>		<u>2576</u>		
H. <u>edell</u>		<u>2600</u>		
Tr <u>w Ed</u>		<u>2610</u>		
Dg <u>929C</u>		<u>2634</u>		
Bl <u>J. Ft</u>		<u>2670</u>		
L.				Geol.
K.C.				
B.K.C.				Conts.
Co.				<u>Michaelis</u>
C.				
M.				Pool
M.				<u>Hugoton</u>
K.				
Ms.				
Mo.				
V.				
S.				
S.				
A.				
R.				
PE				
G.				
TD	<u>2540</u>			

COMPLETE

Date Comm. MAR 7 1956

Location FEB 8 '56 ✓ FEB 15 '56 2-8-56
10 3/4 523 / 350 7" @ 2533
1750 WACT FEB 22 '56 CO DD 2700
FEB 29 " 5 1/2 " 5144' @ 2700 RD
12 hr BD 1,75 MCF @ 17hr
BD 1,216 MCF @ 13 hr Frac 17
hr BD 2,400 MCF MAR 7 '56 72-20
3,676 MCF RP 399#

