


Section 16 Township 25 Range 33-W

Well No. #1 McWilliams "F"

Company Cities Service
Hugoton Pool

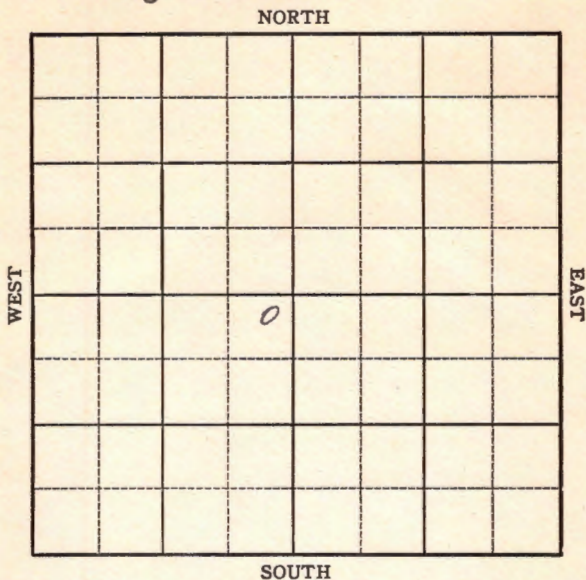

Finney

KANSAS

Sec. 16 Twp. 25 R. 33W ✓

Well No. #1 McWilliams "F" Farm

Cities Service Company

Corbett & Barber Contractor

Hugoton Pool


100' Ft. from N. Line

Ft. from S. Line

100' Ft. from E. Line

Ft. from W. Line

NE SW

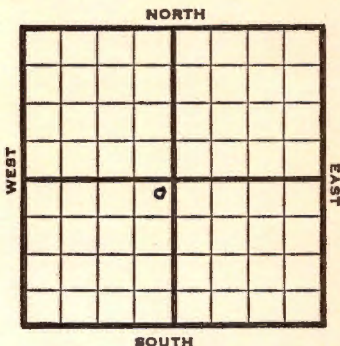

1949

Elev. 2922' REPORT

11/9

Location.

11/16

8" @ 876'

TD 2705

5" @ 2704'

280 shots 2540-2684

22500 acid

11/23

"

11/29

"

12/7

"

12/14

5" @ 2704'

Perf

Acid 2900

Gas 17,800,000

R. Pr. 426#

TD 2705'

COMPLETED

Map No. _____ Sec. 16 Twp. 25 R. 33W

Well No. 1 McWilliams "F"

_____ Cities Service _____ Company

_____ Corbett & Barber _____ Contractor

NE SW

**FIRST REPORT
SECTION PLAT**

100 Ft. from N. Line

_____ Ft. from S. Line

100 Ft. from E. Line

_____ Ft. from W. Line

	0		

Finney County

Location X

Rig up _____

Drilling and Remarks: _____

RECORD

Cased _____ in., _____ ft.

Sand _____

Gas _____

Oil _____

Total Depth _____

PRODUCTION

1st 24 hrs. Nat. _____

1st 24 hrs. after shot _____

Gas _____ Cu. Ft.

Dry Hole _____

Abandoned _____

Date

NOV 9 1949

19

S. J. LEWIS

Scout

Map No. _____ Sec. 16 Twp. 25 R. 33W

Well No. 1 McWilliams "F"

Cities Service

Company

COMPLETE

Contractor

NE SW


E 12922
SECTION PLAT

100 Ft. from N. Line

_____ Ft. from S. Line

100 Ft. from E. Line

_____ Ft. from W. Line

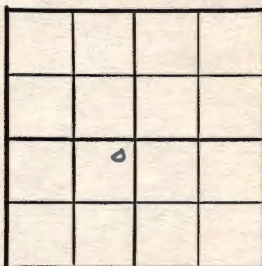

Finney County

Location _____

Rig up _____

Drilling and Remarks:

5" @ 270 ft

Perf.

2800000 cu. ft.

17,500,000 Gas

426 R/B

RECORD

Cased _____ in., _____ ft.

Sand _____

Gas _____

Oil _____

Total Depth 2705

PRODUCTION

1st 24 hrs. Nat. _____

1st 24 hrs. after shot _____

Gas _____ Cu. Ft.

Dry Hole _____

Abandoned _____

Date

DEC 14 1949

19

S. J. LEWIS Scout