


Section 27 Township 25 Range 33-W

Well No. #1 Grussel "D"

Company C S O
Hugoton Pool

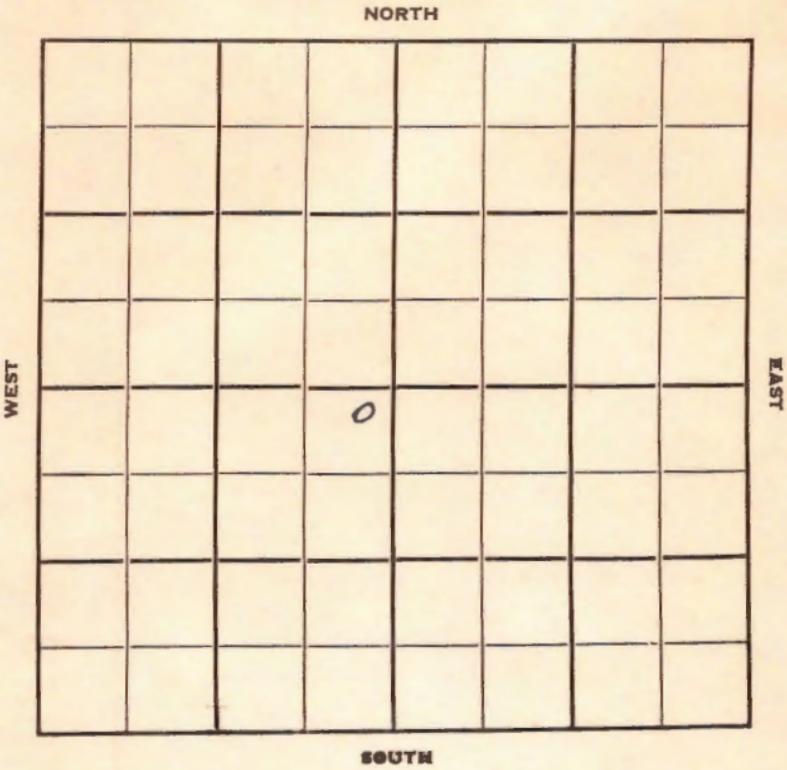

Sec. 27 Twp. 25 R. 33W

Well No. #1 Grussell "D" Farm

C S O Company

Contractor

Hugoton Pool


100' Ft. from N. Line

Ft. from S. Line

100' Ft. from E. Line

Ft. from W. Line

NE SW

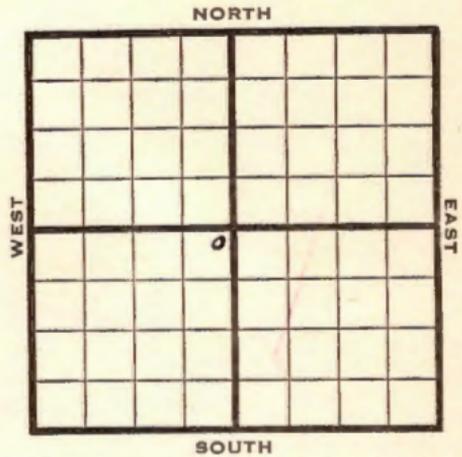

1949

REPORT

10/26 Location

11/1 "

11/9 "

11/16 "

11/23 "

11/29 "

12/7 8" @ 800'

TD 2710'

5 @ 2709'

12/14 360 shots 2546-2690 - 19,000 acid

1950

1/4 TD 2710'

8" @ 800'

5" @ 2709'

Herr 2510'

Krider 2538'

Winfield 2592'

Tawanda 2654'

19,000 acid

5,010 Mcf

433#

Comp

COMPLETED

Map No. _____ Sec. 27 Twp. 25 R. 33W

Well No. 1 Grussel "D"

C S O Company

Contractor

NE SW

**FIRST REPORT
SECTION PLAT**

100 Ft. from N. Line

_____ Ft. from S. Line

100 Ft. from E. Line

_____ Ft. from W. Line

		o	

Finney County

Location X

Rig up _____

Drilling and Remarks: _____

RECORD

Cased _____ in., _____ ft.

Sand _____

Gas _____

Oil _____

Total Depth _____

PRODUCTION

1st 24 hrs. Nat. _____

1st 24 hrs. after shot _____

Gas _____ Cu. Ft.

Dry Hole _____

Abandoned _____

Date

OCT 26 1949 19

S. J. LEWIS Scout

KANSAS

Hugoton Pool

Map No. _____ Sec. 27 Twp. 25 R. 33W

Well No. 1 Grussel "D"

Cities Service Company

Contractor

NE SW

SECTION PLAT

100 Ft. from N. Line

_____ Ft. from S. Line

100 Ft. from E. Line

_____ Ft. from W. Line

	0		

Finney County

Location _____

Rig up _____

Drilling and Remarks:

8" @ 800
 5" @ 2709
 Kern. 2510
 Kinder 2538
 Winfield 2592
 Lawrence 2654
 19,000 acid
 5,010 met
 4330#

RECORD

Cased _____ in., _____ ft.

Sand _____

Gas _____

Oil _____

Total Depth 2710

PRODUCTION

1st 24 hrs. Nat. _____

1st 24 hrs. after shot _____

Gas _____ Cu. Ft.

Dry Hole _____

Abandoned _____

Date

JAN 4 1950

19

J. E. Lynn Scout