


Section 33 Township 25S Range 33W

Well No. #1 Gann

Company Cities Service

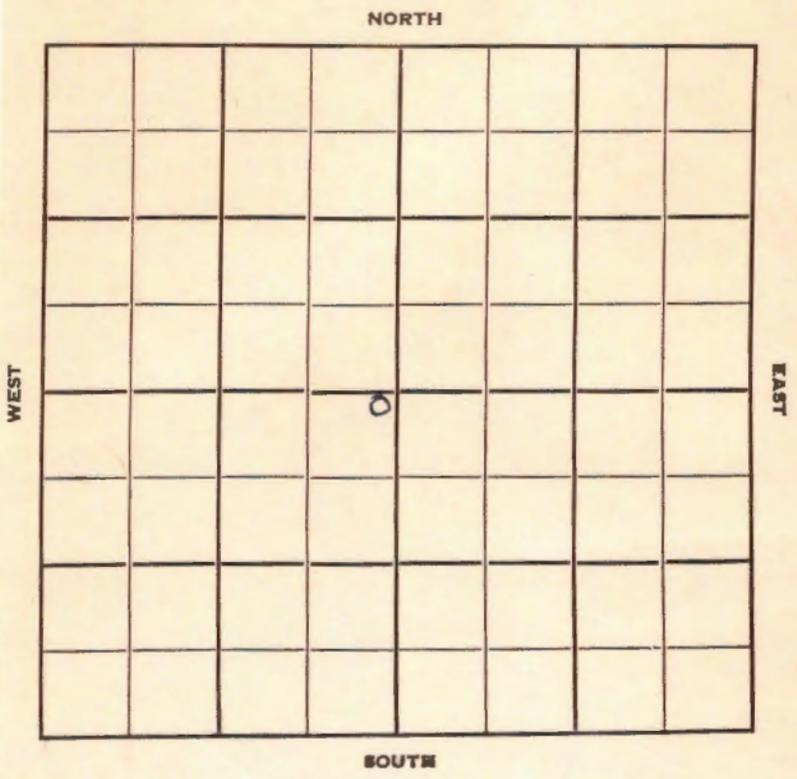

Sec. 33 Twp. 25 R. 33-W ✓

Well No. #1 Gann Farm _____

Cities Service

Company _____

Cont-- Corbett & Barber

NORTH

100

Hugoton


Ft. from N. Line

_____ Ft. from S. Line

100

Ft. from E. Line

_____ Ft. from W. Line

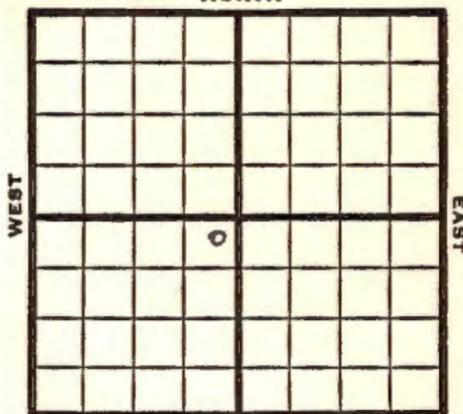

NE SW

SOUTH

1949

Elev 2936'

REPORT

10/12

Location

10/19

8" @ 759'

Drlg 1260'

10/26

TD 2720'

5" @ 2719'

11/1

"

11/9

"

11/16

"

11/23

"

11/29

"

12/7

"

12/14

130 shots 2662-88 - 6500 acid

12/21

"

12/28

"

1950

1/11

TD 2720'

8" @ 759'

5" @ 2719'

Hev 2516'

Kr 2545'

Win 2601'

Tow 2656'

Perf 130/2662-88

Perf 60/2614-24'

Perf 40/2600-08'

Perf 70/2570-84

Perf 70/2552-66

used 38000 acid

Comp for 9 million cu ft gas

open flow per day

Comp

COMPLETED

Map No. _____ Sec. 33 Twp. 25 R. 33W

Well No. 1 Gann

Cities Service _____ Company

Corbett & Barber _____ Contractor

NE SW

FIRST REPORT
SECTION PLAT

100 Ft. from N. Line

_____ Ft. from S. Line

100 Ft. from E. Line

_____ Ft. from W. Line

	o		

Finney County

Location X

Rig up _____

Drilling and Remarks:

RECORD

Cased _____ in., _____ ft.

Sand _____

Gas _____

Oil _____

Total Depth _____

PRODUCTION

1st 24 hrs. Nat. _____

1st 24 hrs. after shot _____

Gas _____ Cu. Ft.

Dry Hole _____

Abandoned _____

Date

OCT 12 1949 19

S. J. LEWIS Scout

Map No. _____ Sec. 33 Twp. 25 R. 33W

Well No. 1 Gann

Cities Service Company

Contractor

NE SW

E. W. 2936
SECTION PLAT

100 Ft. from N. Line

_____ Ft. from S. Line

100 Ft. from E. Line

_____ Ft. from W. Line

	COMPLETE		
	o		

Finney County

Location _____

Rig up _____

Drilling and Remarks:

8" @ 759
5" @ 2719
Ker 2516
Kr. 2545
Win 2601
Jaw 2656

(over)

RECORD

Cased _____ in., _____ ft.

Sand _____

Gas _____

Oil _____

Total Depth 2720

PRODUCTION

1st 24 hrs. Nat. _____

1st 24 hrs. after shot _____

Gas _____ Cu. Ft.

Dry Hole _____

Abandoned _____

Date

JAN 14 1950

19

J. E. TYRA

Scout

Perf 130/2662-88

" 60/2614-24

" 40/2600-08

" 70/2570-84

" 70/2552-66

used 38000 acid

Complete for

9 Million Cuft gas

Open flow per day.

JAN 16 1950

Scout Cards *Earth*

Land Small Map

Land Wall Map *67*

Tracings

France Map

Pierce Map

Misc.