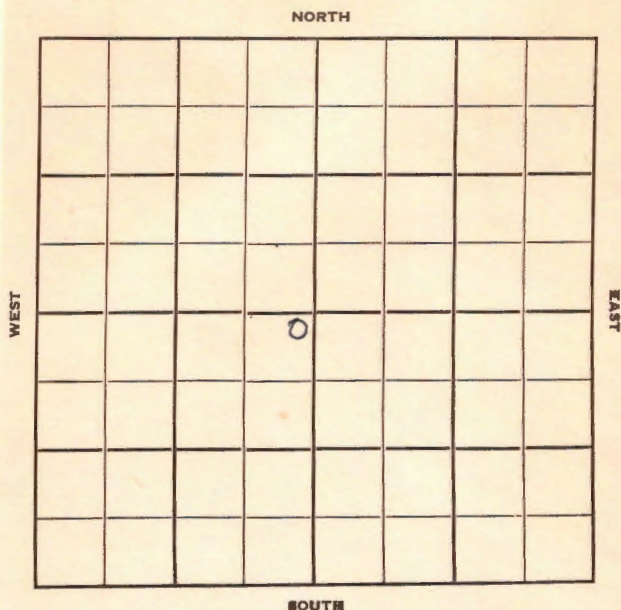


KANSAS

Finney

Section 32 Township 25S Range 33WWell No. #1 EnglerCompany Cities Service

Sec. 32 Twp. 25 R. 33-W

Well No. #1 Engler Farm

Cities Service

Company

Cont Corbett & Barber

NORTH

Hugoton Pool

100 Ft. from N. Line


Ft. from S. Line

100 Ft. from E. Line

Ft. from W. Line

NE SW

WEST

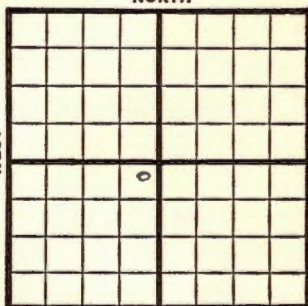

SOUTH

1949 Elev. 2930' REPORT

10/5 Location

10/12 8" @ 759'

Drlg 2546'

10/19 TD 2707'

5" @ 2706'

10/26 "

11/1 "

11/9 "

11/16 "

11/23 "

11/29 "

12/7 370 shots 2540-2680'

19500 acid

12/14 Acid 23,500'

12/28 5" @ 2706

Perf

Acid 23,500

Gas 15,500,000

R. Pr. 396#

TD 2707'

COMPLETED

Kansas

Hugoton Pool

Map No. _____ Sec. 32 Twp. 25 R. 33WWell No. 1 Engler

Cities Service

Company

Corbett & Barber

Contractor

NE SW

FIRST REPORT
SECTION PLAT100 Ft. from N. Line

_____ Ft. from S. Line

100 Ft. from E. Line

_____ Ft. from W. Line

Finney County

Location x

Rig up _____

Drilling and Remarks:

RECORD

Cased _____ in., _____ ft.

Sand _____

Gas _____

Oil _____

Total Depth _____

PRODUCTION

1st 24 hrs. Nat. _____

1st 24 hrs. after shot _____

Gas _____ Cu. Ft.

Dry Hole _____

Abandoned _____

Date

OCT 5 1949S. J. LEWIS

Scout

Kansas

Hugoton Pool

Map No. _____ Sec. 32 Twp. 25 R. 33WWell No. 1 Engler

Cities Service

Company

COMPLETE

Contractor


NE SW

E1, 2930
SECTION PLAT100 Ft. from N. Line

_____ Ft. from S. Line

100 Ft. from E. Line

_____ Ft. from W. Line

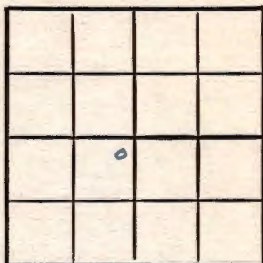

Finney County

Location _____

Rig up _____

Drilling and Remarks:

*5" C 2706**Puff.**20,500 barrel**15,500,000 barrel**3962 R 12*

RECORD

Cased _____ in., _____ ft.

Sand _____

Gas _____

Oil _____

Total Depth 2707

PRODUCTION

1st 24 hrs. Nat. _____

1st 24 hrs. after shot _____

Gas _____ Cu. Ft.

Dry Hole _____

Abandoned _____

Date

DEC 28 1949

19

S. J. LEWIS

Scout