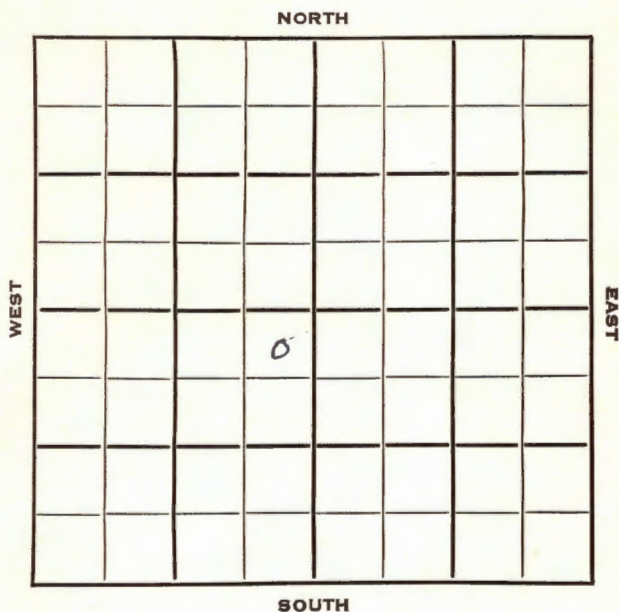


Section 35 Township 25 Range 33WWell No. 1 F. DrussellCompany G. S. Davidson

Sec. 35 Twp. 25 R. 33WWell No. 1 F. Drussell FarmG. S. Davidson Company

Contractor


100 Ft. from N. Line

Ft. from S. Line

100 Ft. from E. Line

Ft. from W. Line

NE SW

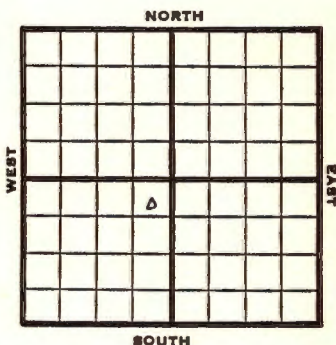

1952

Elev. 2900

REPORT

12/30 RUR
 1/1 RUR
 1/8 9" @ 430 Her 2562 op BR 2580 Win 2618
 RTD 2620 7" @ 2620
 1/22 CO 2580'
 1/29 NR
 2/5 "
 2/12 "
 2/19 NR
 2/26 N.R.
 3/12 "
 3/19 NR
 3/25 Spud 12-27-52
 Gas Well
 TD 2646
 9" @ 430
 Her 2562, Kri 2580, Win 2618,
 TD 2620
 7" @ 2620
 CO to 2580 DD 2646 1000A 3000
 dolo-frac SP 2612
 96/2590-2606 108/2564-82 5000 dolo-
 frac.
 Comp. 10,200,000 gas 426#

COMPLETED

County **Finney** State **Kansas**

Sec. **35** (Blk. **25** (Sur. **33W** Map No.

Operator **G. S. Davidson**

Well No. **1** Farm **F. Drussell**

Elev.	Location	NE	SW

FIRST REPORT

100 Ft. From N Line SW

100 Ft. From E Line Quarter

1st. Report DEC 30 1952

Completion

Remarks

Spudding Date _____

Drig. Data

R U R

J. G. McGEHEE

County Finney State Kansas
 Sec. 35 (Blk.) 25 (Sur.) 33W Map No. _____
 Operator G. S. Davidson
 Well No. 1 Farm F. Drussell
 Elev. 2900 Location NE SW



100 Ft. From N Line SW
100 Ft. From E Line Quarter

1st. Report

Completion MAR 25 1953

Remarks

Spudding Date 12-27-52

Drig. Data Gas well TD 2646
9" @ 430 Her. 2562 Kri. 2580
Win. 2618 TD 2620 7" @ 2620 CO to 2580
DD 2646 1000 A 3000 dolo-frac SP 2612
96/ 2590-2606 108/ 2564-82 5000 dolo-
frac Comp. 10,200,000 gas 426#

J. G. McGEHEE