


Section 1 Township 25 Range 33W

Well No. #5 Kansas (B)

Company Skelly

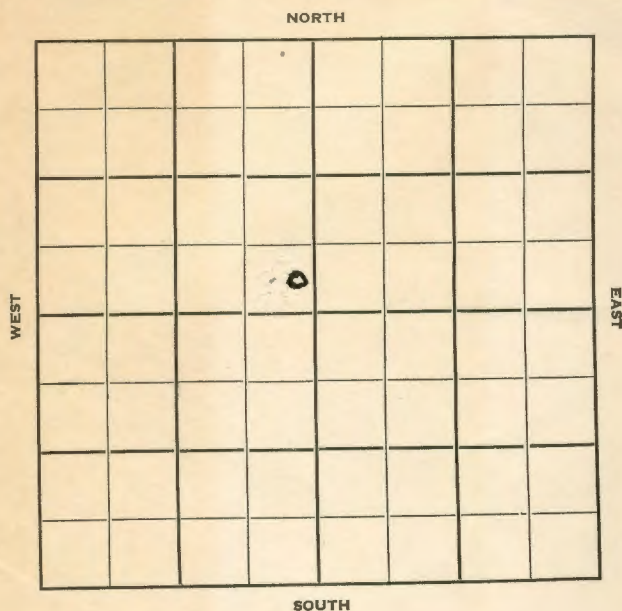


Sec. 1 Twp. 25 R. 33W

Well No. #5 Kansas (B) Farm

Skelly Company

Contractor

Ft. from N. Line
330
Ft. from S. Line
130
Ft. from E. Line
Ft. from W. Line
SE SE NW

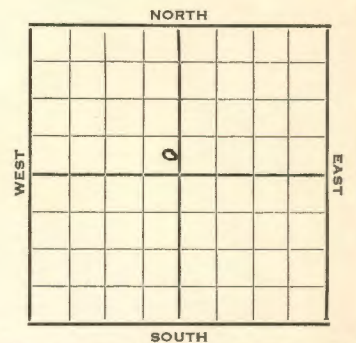

1952 Elev. 2883' REPORT

5/28 Spud 5-25-52
10" @ 346' WOC
6/11 Her 2504 Kri 2533
RTD 2536 7" @ 2534'
6/18 WOCT
6/25 "
7/2 Low Krider 2555'
DD 2575' 2000 A
7/9 1000 A DD 2666' TD 25,000 A
7/17 NR
7/23 Spud 5-25-52
Gas Well TD 2666' 10" @ 346
Heb. 2504 Kri. 2533
7" @ 2534 TD 2666' Odell 2575'
Win 2590 19300 A
Comp. 6,800,000 gas

COMPLETED

County Finney State Kansas
 Sec. 1 (Blk. 25 (Sur. 33W Map No.
 Operator Skelly Oil
 Well No. 5 Farm Kansas "B"
 Elev. 2883 Location SE SE NW



330 Ft. From S Line NW
130 Ft. From E Line Quarter


1st. Report
 Completion JUL 23 1952
 Remarks

Spudding Date 5-25-52

Drig. Data Gas well TD 2666
10" @ 346 Her. 2504 Kri. 2533
7" @ 2534 TD 2666 Odeall 2575
Win. 2590 19300 A
Comp. 6,800,000 gas

J. G. McGEHEE

County Finney State Kansas
 Sec. 1 (Blk. 25 (Sur. 33W Map No.
 Operator Skelly
 Well No. 5 Farm Kansas (B)
 Elev. Location SE SE NW

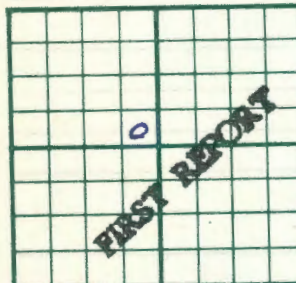

330 Ft. From S Line NW
130 Ft. From E Line Quarter

1st. Report MAY 28 1952

Completion

Remarks

Spudding Date 5-25-52

Drig. Data
10" @ 346 WOC

J. G. McGEHEE