

Finney

Sec. 5 Twp. 25 R. 33W

Well No. #1 Spratt "B" Farm

Cities Service

Company

Hugoton Pool


100' Ft. from N. Line

Ft. from S. Line

100' Ft. from E. Line

Ft. from W. Line

NE SW

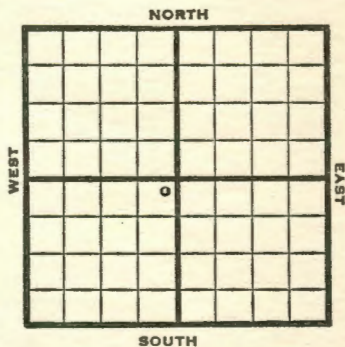

1949 **Elev 2917'** REPORT

9/21	Location
9/28	"
10/5	"
10/12	8" @ 740'
	TD 2730'
	5" @ 2729'
10/12	"
10/26	340 shots 2552-2690 - 27,000 acid
11/1	"
11/9	"
11/16	TD 2730'
	5" @ 2729'
	Perf
	27000 acid
	17 M Gas
	410# R Pr.
	Comp

COMPLETED


Finney

Section 5 Township 25 Range 33W

Well No. 1 Spratt "B"

Company Cities Service

Hugoton

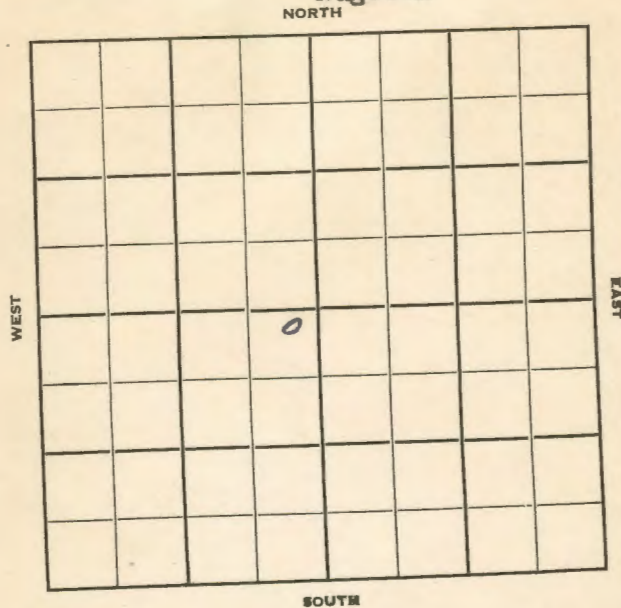

Form 26 200 Bks. 6-49 Petrol
Kansas

Hugoton Pool

Map No. _____ Sec. 5 Twp. 25 R. 33W

Well No. 1 Spratt "B"

Cities Service Company

COMPLETE

Contractor

NE SW

SECTION PLAT

100 Ft. from N. Line

Ft. from S. Line

100 Ft. from E. Line

Ft. from W. Line

Finney County

Location

Rig up

Drilling and Remarks:

5" x 2 1/2"

Prof.
2700' sand

17M. Gas

410 * 2 1/2"

Date

NOV 16 1949

S. J. LEWIS

Scout

RECORD

Cased _____ in., _____ ft.

Sand _____

Gas _____

Oil _____

Total Depth 2234

PRODUCTION

1st 24 hrs. Nat. _____

1st 24 hrs. after shot _____

Gas _____ Cu. Ft.

Dry Hole _____

Abandoned _____

Form 26 200 Bks. 6-49 Petrol
Kansas

Hugoton Pool

Map No. _____ Sec. 5 Twp. 25 R. 33W

Well No. 1 Spratt "B"

Cities Service Company

Contractor

NE SW

FIRST REPORT
SECTION PLAT

100 Ft. from N. Line

Ft. from S. Line

100 Ft. from E. Line

Ft. from W. Line

Finney County

Location x

Rig up

Drilling and Remarks:

RECORD

Cased _____ in., _____ ft.

Sand _____

Gas _____

Oil _____

Total Depth _____

PRODUCTION

1st 24 hrs. Nat. _____

1st 24 hrs. after shot _____

Gas _____ Cu. Ft.

Dry Hole _____

Abandoned _____

Date

SEP 21 1949

S. J. LEWIS

Scout