


Finney

KANSAS

Section 7 Township 25 Range 33WWell No. #1 Spratt (F)Company Cities Service Oil Co.

NORTH

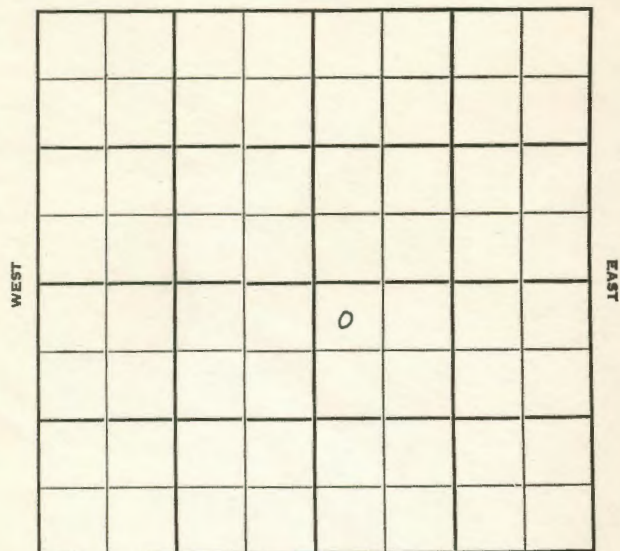

SOUTH

Finney

KANSAS

Sec. 7 Twp. 25 R. 33 WWell No. #1 Spratt (F)

Farm

Cities Service Oil Co.

Company

Contractor

Hugoton Pool

100 Ft. from N. Line


Ft. from S. Line

Ft. from E. Line

100 Ft. from W. Line

NW NW SE

NORTH

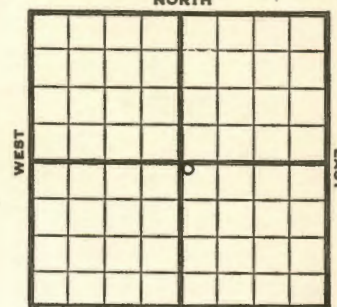

SOUTH

1951

Elev. 2939'

REPORT

6/20

Location

9/19

Spud 6-20-51

Gas Well TD 2730

8" @ 718

5" @ 2729

TD 2730

Her. 2534 Kri 2564

Win 2611 Ft. Riley 2672

CO to 2712 110/2686-2708

50/2672-82 50/2624-34

40/2610-18 70/2580-94

60/2564-76 24,500 A

Comp. 15,100,000 gas 405#

COMPLETED

