


KANSAS

Finney

Section 9 Township 25 Range 34WWell No. 20 BrownCompany Northern Natural Gas

Hugoton

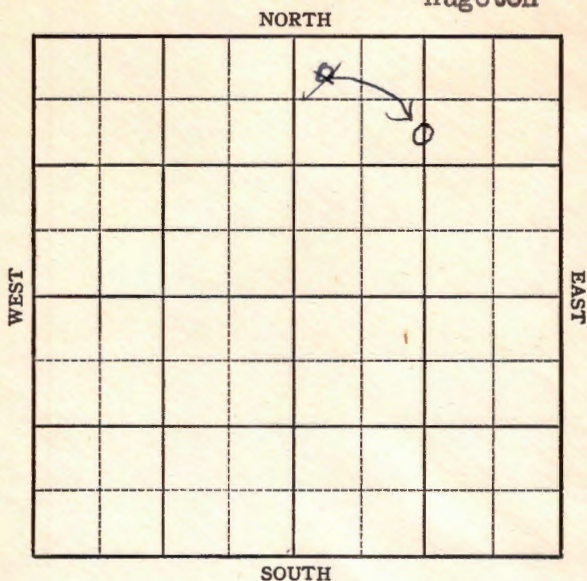

Finney

KANSAS



Sec. 9 Twp. 25 R. 34W

Well No. #20 Brown Farm

Northern Natural Gas

Company

Hugoton Pool (Moran, Cont.) NORTH


330' Ft. from N. Line

 Ft. from S. Line

1320' Ft. from E. Line

330' Ft. from W. Line

05L N 1/2 NE
NW NE

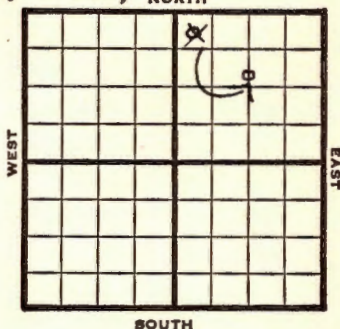

1949

Elev 2966'

REPORT

7/13 10" @ 397'
7/20 TD 2475'
7" @ 2462'
7/27 TD 2700
252' of 5" Perf Liner @ 2700'
8/3 Acid 21,000
8/10 TD 2700
7" @ 2462'
252 of 5" liner @ 2700'
21000 acid
27,245,000 Gas
408# R Pr.
Comp

COMPLETED

Map No. Sec. 9 Twp. 25 R. 34W

Well No. 20 Brown

Northern Natural Gas Company

Moran Contractor

NW NE

**FIRST REPORT
SECTION PLAT**

330 Ft. from N. Line

 Ft. from S. Line

 Ft. from E. Line

330 Ft. from W. Line

		0	

Finney County

Location

Rig up

Drilling and Remarks:

10" @ 397

RECORD

Cased in., ft.

Sand

Gas

Oil

Total Depth

PRODUCTION

1st 24 hrs. Nat.

1st 24 hrs. after shot

Gas Cu. Ft.

Dry Hole

Abandoned

Date

JUL 13 1949

19

S. J. LEWIS

Scout

Hugoton Pool

Map No. 1 Sec. 9 Twp. 25 R. 34W

Well No. 20 Brown

Northern Natural & Gas Company

CORRECTION Contractor

C S L N $\frac{1}{2}$ NE


SECTION PLAT

1120 Ft. from N. Line

 Ft. from S. Line

1320 Ft. from E. Line

 Ft. from W. Line

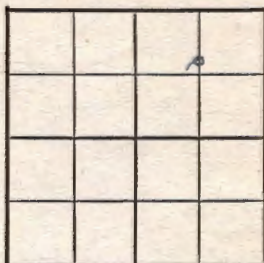

Finney County

Location

Rig up

Drilling and Remarks:

Reported
NW NE

RECORD

Cased in., ft.

Sand

Gas

Oil

Total Depth

PRODUCTION

1st 24 hrs. Nat.

1st 24 hrs. after shot

Gas Cu. Ft.

Dry Hole

Abandoned

Date

JUL 20 1949 19

S. J. LEWIS Scout

Map No. 1 Sec. 9 Twp. 25 R. 34W

Well No. 20 Brown

Northern Natural Gas

Company

COMPLETE

Contractor

C S L N $\frac{1}{2}$ NE


E/2566
SECTION PLAT

1126 Ft. from N. Line

Ft. from S. Line

1320 Ft. from E. Line

Ft. from W. Line

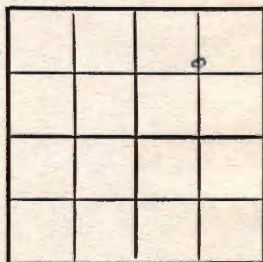

Finney County

RECORD

Location _____

Cased _____ in., _____ ft.

Rig up _____

Sand _____

Drilling and Remarks:

Gas _____

7" @ 2462

Oil _____

Total Depth 2700

252' of 5" line @

PRODUCTION

2700

1st 24 hrs. Nat. _____

21000 and 1/2

1st 24 hrs. after shot _____

27,245,000 gal

Gas _____ Cu. Ft.

Dry Hole _____

Abandoned _____

Date

AUG 10 1949 19

S. J. LEWIS

Scout