

Finney


Form 51-5M-11-31-Palace

Map No. **KANSAS** Sec. *16* Twp. *25* R. *34^W*

Well No. *1-Brown* Farm

Joe Denham et al Company

NORTH

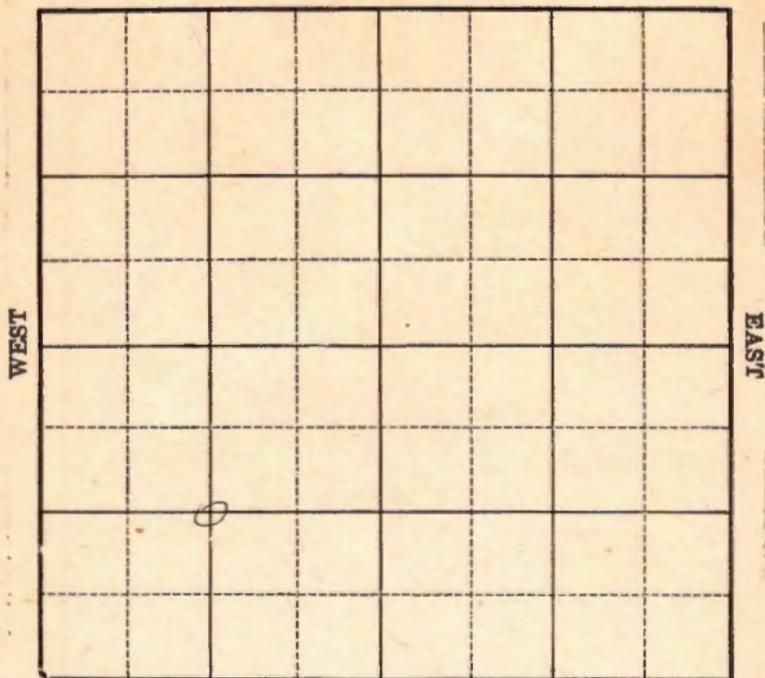

SOUTH

Location _____

Drilling Remarks _____

RECORD

Cased _____ in. _____ ft.

Sand _____

Gas _____

Oil _____

Total Depth _____

Rig Up _____

Drilling Remarks _____

PRODUCTION

1st 24 hrs. Nat. _____

1st 24 hrs. after shot _____

Gas _____ cu. ft.


Dry Hole _____

Abandoned _____

Map No. **KANSAS** Sec. 16 Twp. 25 R. 34^W

Well No. 1-Brown Farm
Joe Dentman et al Company

_____ Ft. from N. Line
1320 Ft. from S. Line
_____ Ft. from E. Line
1320 Ft. from W. Line
1932

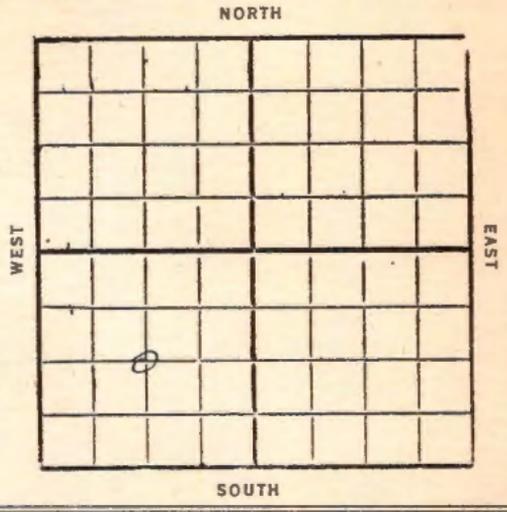

Date	REPORT
8/17	Bedg rotary rig
8/24	Rig
8/31	—
9/7	—
9/14	—
9/21	—
9/30	Moving in tools
10/5	Rig & tools
10/12	Run up
10/19	—
10/26	—
11/2	Drdg 170'
11/9	Drdg 1300'
11/16	" 2000'
11/23	" 2500'
11/30	set 6"-2500' Rust
12/7	Cem 6"-2500' Rust
12/14	—
12/21	Twist show gas 2634 gauge 5 1/4 M gas at 2661 drdg ahead

Finney

W

Map No. _____ Sec. *16* Twp. *75* R. *34*

Well No. *1* *Brown*

Joe Denkman et al Company

Contractor

SECTION PLAT

FIRST REPORTS

_____ Ft. from N. Line

1320 Ft. from S. Line

_____ Ft. from E. Line

1320 Ft. from W. Line

Location _____

Rig up _____

Drilling and Remarks:

Blag Rotary Rig

RECORD

Cased _____ in., _____ ft.

Sand _____

Gas _____

Oil _____

Total Depth _____

PRODUCTION

1st 24 hrs. Nat. _____

1st 24 hrs. after shot _____

Gas _____ Cu. Ft.

Dry Hole _____

Abandoned _____

Date

AUG 17 1932

CHAS. L. SHERWOOD

192

Scout

Jinney

Map No. **KANSAS** Sec. *16* Twp. *25* R. *34*^W

Well No. *1* *Brown*

Joe Dewhman Co Company

Contractor

COMPLETED

SECTION PLAT

..... Ft. from N. Line

1320 Ft. from S. Line

..... Ft. from E. Line

1320 Ft. from W. Line

Location.....

Rig up.....

Drilling and Remarks:

437 # R P

RECORD

Cased *6* in., *2500* ft.

Sand.....

Gas *2525-2742*

Oil.....

Total Depth *2742*

PRODUCTION

1st 24 hrs. Nat.....

1st 24 hrs. after shot.....

Gas *5 1/4* *7A* Cu. Ft.

Dry Hole.....

Abandoned.....

Date

DEC 23 1932

CHAS. L. SHERWOOD

.....192..... Scout