

Finney


FORM 51 5M BRIX

KANSAS

Section 18 Township 25 Range 34W

Well No. #1 Tate

Company Helmerick Payne

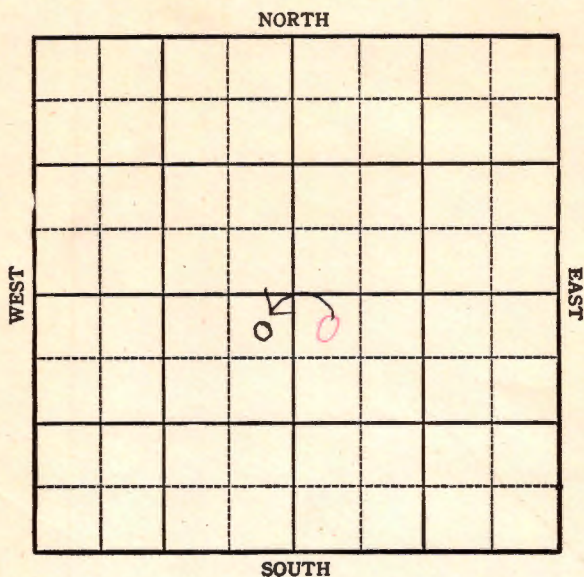

KANSAS

Sec. 18 Twp. 25 R. 34W

Well No. #1 Tate Farm

Helmerick Payne Company


Hugoton

100 Ft. from N. Line

 Ft. from S. Line

100 Ft. from E. Line

100 Ft. from W. Line

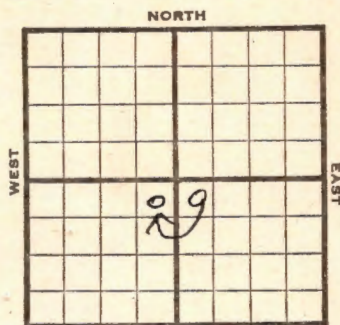

Finney ~~NW~~ ~~SE~~ NE SW SOUTH Elev. 2980

REPORT					
1944					
11/29	RUR.				
12/21	10" @ 670'				
	Drlg. 2100'				
12/29	5" @ 2699' TD 2709' RUST				
1945					
1/3	"	"	"	"	"
1/10	"	"	"	"	"
1/17	"	"	"	"	"
1/26	"	"	"	"	"
1/31	"	"	"	"	"
2/7	"	"	"	"	"
2/14	"	"	"	"	"
2/21	"	"	"	"	"
2/28	"	"	"	"	"
3/7	"	"	"	"	"
3/14	Perf. 41 shots - 2474 - 2648				
3/23	"	"	"	"	"
3/29	"	"	"	"	"
4/5	"	"	"	"	"
4/12	8000 acid.				
4/20	"	"			
4/27	"	"			
5/3	"	"			
5/10	"	"			
5/17	"	"			
OVER					

OVER

1945

5/24	8000 acid.	
5/31	"	"
6/8	"	"
6/14	"	"
6/21	"	"
7/3	5" @ 2699	
	27500 acid.	
	TD 2709	
	21,900,000 Gas.	
	R Pr. 415#	

COMPLETED

Pool Name HugotonMap No. 12/17 Sec. 18 Twp. 25 R. 34WWell No. 1 TateHelmerick Payne

Company

FIRST REPORT

Contractor

NW SE

SECTION PLAT

100 Ft. from N. Line Ft. from S. Line Ft. from E. Line100 Ft. from W. Line

		o	

FinneyLocation Rig up

Drilling and Remarks:

R U R

RECORD

Cased in. ft.Sand Gas Oil Total Depth

PRODUCTION

1st 24 hrs. Nat. 1st 24 hrs. after shot Gas Cu. Ft.Dry Hole Abandoned

Date

NOV 29 1944


19

S. J. LEWIS

Scout

Pool Name HugotonMap No. 111 Sec. 18 Twp. 25 R. 34WWell No. 1 TateHelmerick & Payne Company**CORRECTION**

Contractor

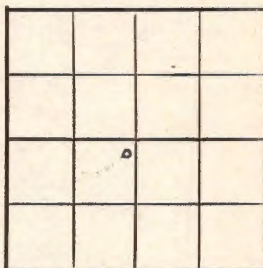NE SW**SECTION PLAT**100 Ft. from N. Line Ft. from S. Line100 Ft. from E. Line Ft. from W. LineFinneyLocation Rig up Drilling and Remarks:
reported NW SE**RECORD**Cased in., ft.Sand Gas Oil Total Depth **PRODUCTION**1st 24 hrs. Nat. 1st 24 hrs. after shot Gas Cu. Ft.Dry Hole Abandoned

Date


DEC 6 1944 19S. J. LEWIS Scout

KANSAS

Kansas Pool Name HugotonMap No. no map Sec. 18 Twp. 25 R. 34WWell No. 1 TateHelmerick & Payne Company**COMPLETED**

Contractor

NE SW

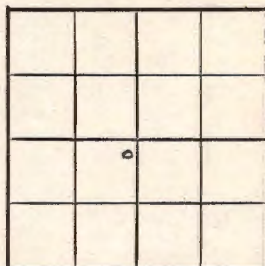E 12980
SECTION PLAT100 Ft. from N. Line Ft. from S. Line100 Ft. from E. Line Ft. from W. LineFinney CountyLocation Rig up

Drilling and Remarks:

5-10-268927500 Acid21,900,000 Gas415 # R R**RECORD**Cased in., ft.Sand Gas Oil Total Depth 2709**PRODUCTION**1st 24 hrs. Nat. 1st 24 hrs. after shot Gas Cu. Ft.Dry Hole Abandoned

Date

JUL 3 1945 19S. J. LEWIS Scout