

Hugoton

SOUTH

KANSAS

Finney

Sec. 3 Twp. 25 R. 34W ✓

Well No. #16 Brown Farm

Northern Natural Gas Company

Hugoton Pool


 Ft. from N. Line

1320' Ft. from S. Line

 Ft. from E. Line

1320' Ft. from W. Line

C SW

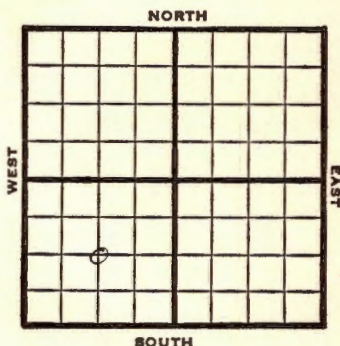

1949

Elev 2963'

R E P O R T

6/22

Location

6/28

10" @ 390'

7/6

"

7/12

7" @ 2450'

TD 2674'

237' of 5" Perf liner @ 2674

21,400 acid

7/20

"

7/27

"

8/3

"

8/10

TD 2674'

7" @ 2450'

237' of 5" Liner @ 2674'

21000 acid

24,700,000 Gas

407# R Pr.

Comp

COMPLETED

Kansas

Hugoton Pool


Map No. _____ Sec. 3 Twp. 25 R. 34WWell No. 16 Brown

Northern Natural Gas Company

Contractor

C SW

FIRST SECTION PLAT

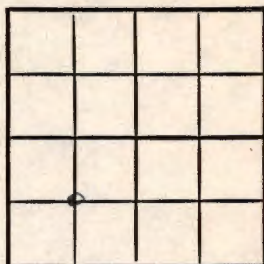

_____ Ft. from N. Line

1320 Ft. from S. Line

_____ Ft. from E. Line

1320 Ft. from W. Line

Finney County

Location X

Rig up _____

Drilling and Remarks:

RECORD

Cased _____ in., _____ ft.

Sand _____

Gas _____

Oil _____

Total Depth _____

PRODUCTION

1st 24 hrs. Nat. _____

1st 24 hrs. after shot _____

Gas _____ Cu. Ft.

Dry Hole _____

Abandoned _____

Date

JUN 22 194919S. J. LEWISScout

Kansas


Hugoton Pool

Map No. Sec. 3 Twp. 25 R. 34WWell No. 16 BrownNorthern Natural Gas Company

COMPLETE

Contractor

C SW

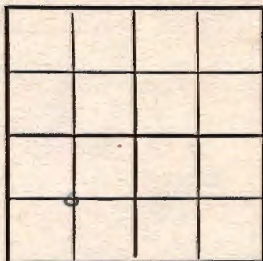E 12963
SECTION PLAT Ft. from N. Line1320 Ft. from S. Line Ft. from E. Line1320 Ft. from W. LineFinney County

RECORD

Location Cased in., ft.Rig up Sand

Drilling and Remarks:

Gas Oil Total Depth 2674

PRODUCTION

1st 24 hrs. Nat. 1st 24 hrs. after shot Gas Cu. Ft.Dry Hole Abandoned

Date

AUG 10 1949 19S. J. LEWIS Scout