

KANSAS


Finney

Section 5 Township 25 Range 34W

Well No. 5 Wagner

Company Woodriver Oil & Ref.

Hugoton Pool

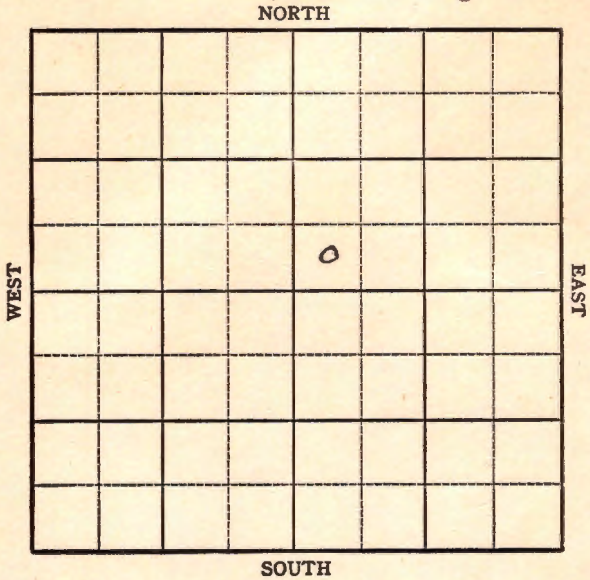

KANSAS

Finney



Sec. 5 Twp. 25 R. 34W

Well No. #5 Wagner Farm

Woodriver Oil & Ref.

Company

Hugoton Pool

 Ft. from N. Line

330'


 Ft. from S. Line

 Ft. from E. Line

330'

 Ft. from W. Line

SW NE

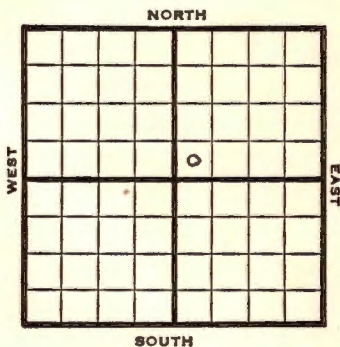

1948

Elev 2978'

R E P O R T

10/20 Location

10/26 "

11/3 Drlg 500'

11/10 Drlg 2242'

11/16 TD 2675

5" @ 2658'

11/23 "

11/30 "

12/6 "

12/14 "

12/22 "

12/29 "

1/5 "

1/12 "

1/19 "

1/26 190 shots 2490-2564

150 shots 2602-32

80 shots 2658-74

24500 acid

2/2 "

2/9 TD 2675'

5" @ 2658'

Perf 24,500 acid

21,500,000 Gas

407# R Pr.

Comp

COMPLETED

Map No. _____ Sec. 5 Twp. 25 R. 34W

Well No. 5 Wagner

Woodriver Oil & Ref. Company

FIRST REPORT Contractor

SW NE

SECTION PLAT

_____ Ft. from N. Line

330 Ft. from S. Line

_____ Ft. from E. Line

330 Ft. from W. Line

Finney County

Location X

Rig up _____

Drilling and Remarks:

RECORD

Cased _____ in., _____ ft.

Sand _____

Gas _____

Oil _____

Total Depth _____

PRODUCTION

1st 24 hrs. Nat. _____

1st 24 hrs. after shot _____

Gas _____ Cu. Ft.

Dry Hole _____

Abandoned _____

Date

OCT 20 1948 19

S. J. LEWIS

Scout

Hugotini

Map No. _____ Sec. 5 Twp. 25 R. 34W

Well No. 5 Wagner

Woodward & Ray Company

COMPLETE

Contractor

SWNE

E. 1975


SECTION PLAT

_____ Ft. from N. Line

230 Ft. from S. Line

_____ Ft. from E. Line

330 Ft. from W. Line

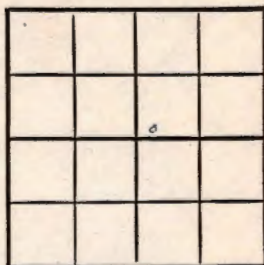

Finney

Location _____

Rig up _____

Drilling and Remarks:

5' 10 265'
Ref.
24000 acid
21,500,000 Gas

405 R/R

RECORD

Cased _____ in., _____ ft.

Sand _____

Gas _____

Oil _____

Total Depth 2625

PRODUCTION

1st 24 hrs. Nat. _____

1st 24 hrs. after shot _____

Gas _____ Cu. Ft.

Dry Hole _____

Abandoned _____

Date

FEB 9 1949 19

S. J. LEWIS Scout