

KANSAS

FORM 51 IOM 12-46 PETROL

Finney County

Section 6 Township 25 Range 34-W

Well No. 7 Hamlin


Company Kansas Natural Gas

Hugoton Pool

NORTH

WEST

EAST

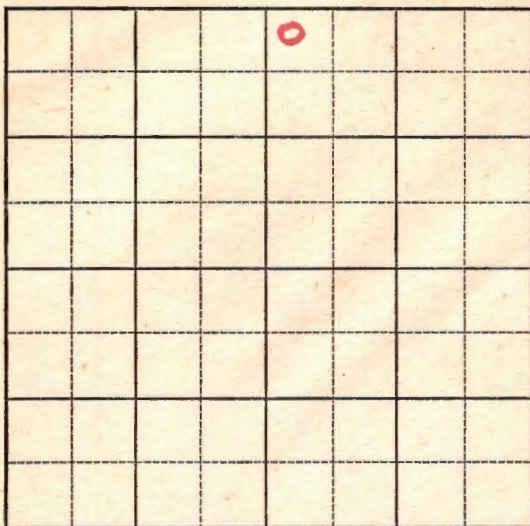

SOUTH

Sec. 6 Twp. 25 R. 34-W

Well No. #7 Hamlin Farm

Kansas Natural Gas Company


Hugoton Pool

300 Ft. from N. Line

 Ft. from S. Line

 Ft. from E. Line

300 Ft. from W. Line

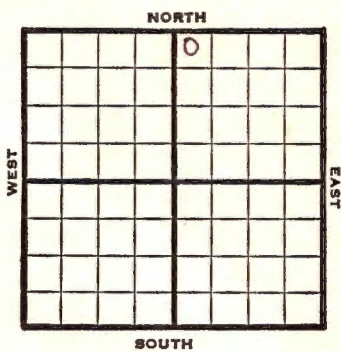

NW NE

El v. 2977: REPORT

1947

7/2 10" @ 566'
Drlg 2200'

7/8 TD 2676'
7" @ 2666'

7/16 "

7/22 "

7/29 "

8/6 "

8/13 84 shots to 2486-2500
108 " to 2502-20
90 " to 2548-63
216 " to 2596-2632
-57000 acid

8/20 " "

8/27 " "

9/3 " "

9/10 " "

OVER

1947

9/17 7" @ 2666'

Perf

57,000 Acid

28,800,000 Gas

375# Rock Pressure

Total Depth 2676'

COMPLETED

Map No. _____ Sec. 6 Twp. 25 R. 34W

Well No. 7 Hamlin

Kansas Natural Gas Company

FIRST REPORT

Contractor _____

NW NE

SECTION PLAT

300 Ft. from N. Line

_____ Ft. from S. Line

_____ Ft. from E. Line

300 Ft. from W. Line

		Δ	

Finney County

Location _____

Rig up _____

Drilling and Remarks:

10" @ 566
drlg. 2200

RECORD

Cased _____ in., _____ ft.

Sand _____

Gas _____

Oil _____

Total Depth _____

PRODUCTION

1st 24 hrs. Nat. _____

1st 24 hrs. after shot _____

Gas _____ Cu. Ft.

Dry Hole _____

Abandoned _____

Date

JUL 2 1947 19 _____ S. J. LEWIS Scout

Map No. 0 Sec. 6 Twp. 25 R. 34W

Well No. 7 Hamlin

Kansas Natural Gas Company

COMPLETE Contractor

NW NE

E 12977
SECTION PLAT

300 Ft. from N. Line

 Ft. from S. Line

 Ft. from E. Line

300 Ft. from W. Line

		0	

Finney County

Location

Rig up

Drilling and Remarks:

7" @ 2666

Prof.

87000 acid

28,800,000 Gas

875 # R₂

RECORD

Cased in, ft.

Sand

Gas

Oil

Total Depth 2676

PRODUCTION

1st 24 hrs. Nat.

1st 24 hrs. after shot

Gas Cu. Ft.

Dry Hole

Abandoned

Date

SEP 17 1947 19

S. J. LEWIS Scout