


KANSAS

Finney

Section 7 Township 25 Range 34WWell No. 7 WagnerCompany Woodriver Oil & Ref.

Hugoton Pool

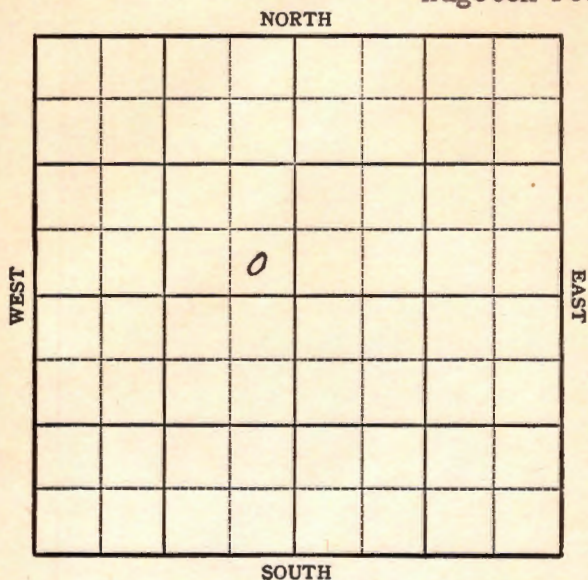

KANSAS

Finney

Sec. 7 Twp. 25 R. 34W

Well No. #7 Wagner Farm

Woodriver Oil & Ref. Company

SE NW

NORTH

 Ft. from N. Line


330' Ft. from S. Line

330' Ft. from E. Line

 Ft. from W. Line

SE NW

WEST

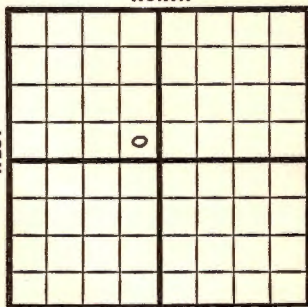

SOUTH

1948 **Elev. 3000'** REPORT

10/20 Drlg. 480'

10/26 8" @ 565'
5" @ 2687'
TD 2695'

11/3 "

11/10 15000 acid

11/16 "

11/23 "

11/30 "

12/6 "

12/14 "

12/22 "

12/29 "

1/5 "

1/12 "

1/19 "

1/26 5" @ 2687'

Perf.

38,000 acid

Gas 12,54,000

R. Pr. 409#

TD 2695'

COMPLETED

Map No. _____ Sec. 7 Twp. 25 R. 34W

Well No. 7 Wagner

Woodriver Oil & Ref. Company

FIRST REPORT Contractor

SE NW


SECTION PLAT

_____ Ft. from N. Line

330 Ft. from S. Line

330 Ft. from E. Line

_____ Ft. from W. Line

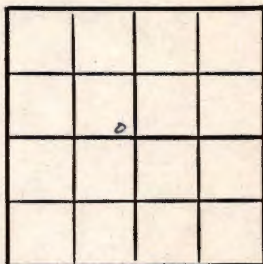

Finney County

Location _____

Rig up _____

Drilling and Remarks:

drlg. 480

RECORD

Cased _____ in., _____ ft.

Sand _____

Gas _____

Oil _____

Total Depth _____

PRODUCTION

1st 24 hrs. Nat. _____

1st 24 hrs. after shot _____

Gas _____ Cu. Ft.

Dry Hole _____

Abandoned _____

Date

OCT 20 1948

19

S. J. LEWIS

Scout

Map No. _____ Sec. 7 Twp. 25 R. 34W

Well No. 7. Wagner

Woodriver Oil & Ref. Company

COMPLETE

Contractor

SE NW


21,3000
SECTION PLAT

_____ Ft. from N. Line

330 Ft. from S. Line

330 Ft. from E. Line

_____ Ft. from W. Line

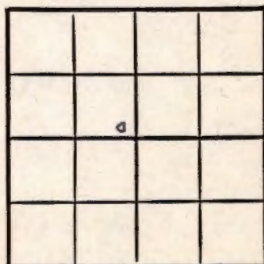

Finney County

Location _____

Rig up _____

Drilling and Remarks:

5-02677

Puf.

3500000

12,540,000 Gas

4094 R/2

RECORD

Cased _____ in., _____ ft.

Sand _____

Gas _____

Oil _____

Total Depth 2685

PRODUCTION

1st 24 hrs. Nat. _____

1st 24 hrs. after shot _____

Gas _____ Cu. Ft.

Dry Hole _____

Abandoned _____

Date

JAN 26 1949

19

S. J. LEWIS

Scout