


KANSAS Finney

Section 8 Township 25 Range 34W

Well No. 8 Wagner

Company Woodriver Oil & Ref.

Hugoton Pool

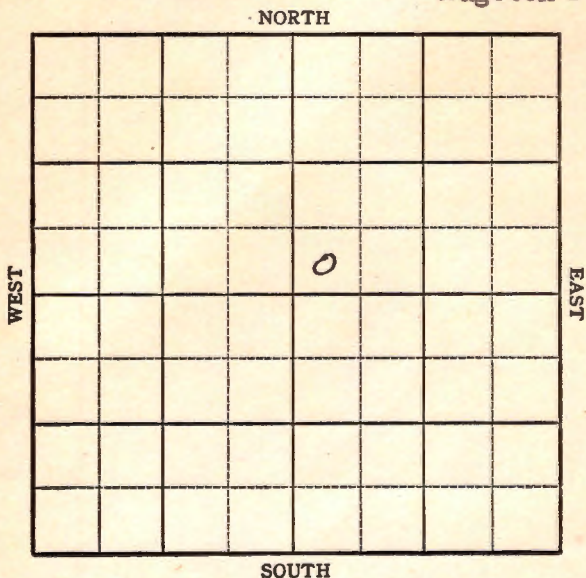

KANSAS

Finney
25

34W

Sec. 8 Twp. 25 R. 34W

Well No. #8 Wagner Farm

Woodriver Oil & Ref. Company

Hugoton Pool


 Ft. from N. Line

330' Ft. from S. Line

 Ft. from E. Line

330' Ft. from W. Line

SW NE

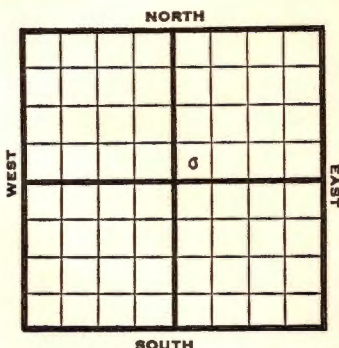

1948

Elev 2981'

REPORT

10/20	Drlg. 565'			
10/26	8" @ 565'			
	Drlg. 2035'			
11/3	TD 2680'			
	5" @ 2658'			
11/10	"	"	"	"
11/16	"	"	"	"
11/23	"	"	"	"
11/30	"	"	"	"
12/6	"	"	"	"
12/14	"	"	"	"
12/22	"	"	"	"
12/29	170	shots	2600-34	
	120	"	2540-64	
	70	"	2508-22	
	70	"	2490-2504 - 2800 acid	
1/5	"	"	"	"
1/12	"	"	"	"
1/19	"	"	"	"
1/26	"	"	"	"
2/2	"	"	"	"
2/9	TD 2680'			
	5" @ 2658'			
	Perf 28000 acid			
	2163000 Gas			
	417# R pr/			
	Comp			

COMPLETED

Map No. _____ Sec. 8 Twp. 25 R. 34W

Well No. 8 Wagner

Woodriver Oil & Ref. Company

FIRST REPORT Contractor

SW NE

SECTION PLAT

_____ Ft. from N. Line

330 Ft. from S. Line

_____ Ft. from E. Line

330 Ft. from W. Line

Finney County

Location _____

Rig up _____

Drilling and Remarks:

drlg. 565

RECORD

Cased _____ in., _____ ft.

Sand _____

Gas _____

Oil _____

Total Depth _____

PRODUCTION

1st 24 hrs. Nat. _____

1st 24 hrs. after shot _____

Gas _____ Cu. Ft.

Dry Hole _____

Abandoned _____

Date

OCT 20 1948

19

S. J. LEWIS

Scout

Kansas

Hugoton

Map No. _____ Sec. 8 Twp. 25 R. 34WWell No. 8 WagnerWoodriver O & Roy

Company


COMPLETE

Contractor

SWNE

L² 1.2957

SECTION PLAT

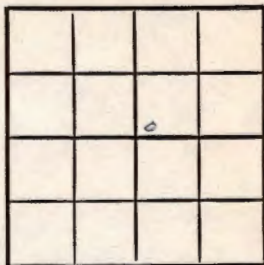

_____ Ft. from N. Line

320 Ft. from S. Line

_____ Ft. from E. Line

320 Ft. from W. LineLocation Finney

Rig up _____

Drilling and Remarks:

5" 02655Pay.25000 acid2,163,000 Gals417 RPL

RECORD

Cased _____ in., _____ ft.

Sand _____

Gas _____

Oil _____

Total Depth 2650

PRODUCTION

1st 24 hrs. Nat. _____

1st 24 hrs. after shot _____

Gas _____ Cu. Ft.

Dry Hole _____

Abandoned _____

Date

FEB 9 1949 19

S. J. LEWIS Scout