


KANSAS FinneySection 11 Township 25 Range 34WWell No. 3 BrownCompany Northern Natural Gas

Hugoton

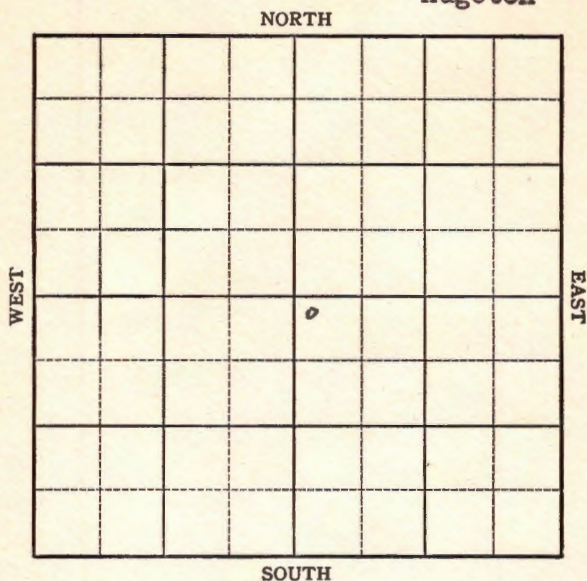

KANSAS

FINNEY
~~Kearny~~



Sec. 11 Twp. 25 R. 34W

Well No. #3 Brown Farm

Northern Natural Gas Company

Hugoton Pool


100' Ft. from N. Line

 Ft. from S. Line

 Ft. from E. Line

100' Ft. from W. Line

NW SE

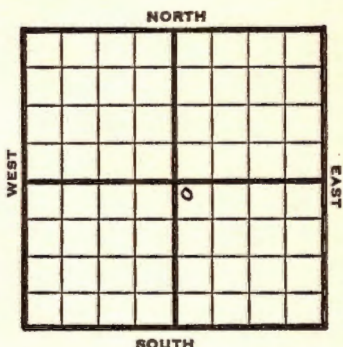

1949

Elev 2942'

R E P O R T

3/30	Location
4/6	Drlg. 700'
4/12	TD 2526' - 7" @ 2503'
4/20	"
4/27	"
5/4	"
5/10	"
5/18	TD 2702' 218' of 5" Perf Liner 2702 15000 acid
5/25	"
6/1	"
6/7	"
6/15	"
6/21	"
6/28	"
7/6	TD 2702' 7"@ 2503' 218' of 5" Perf Liner @ 2702' 15000 acid 22,841,000 Gas 429# R Pr. Comp

COMPLETE

Kansas

Hugoton Pool

Map No. _____ Sec. 11 Twp. 25 R. 34WWell No. 3 Brown_____
Northern Natural Gas Company

CORRECTION

Contractor

NW SE

SECTION PLAT

100 Ft. from N. Line_____
Ft. from S. Line_____
Ft. from E. Line100 Ft. from W. Line

		o	

Finney County

Location _____

Rig up _____

Drilling and Remarks:

Reported in
Kearny County

RECORD

Cased _____ in., _____ ft.

Sand _____

Gas _____

Oil _____

Total Depth _____

PRODUCTION

1st 24 hrs. Nat. _____

1st 24 hrs. after shot _____

Gas _____ Cu. Ft.

Dry Hole _____

Abandoned _____

Date

MAR 30 1949

19

S. J. LEWIS

Scout

Map No. _____ Sec. 11 Twp. 25 R. 34W

Well No. 3 Brown

Northern Natural Gas Company

FIRST REPORT

Contractor

NW SE


SECTION PLAT

100 Ft. from N. Line

_____ Ft. from S. Line

_____ Ft. from E. Line

100 Ft. from W. Line

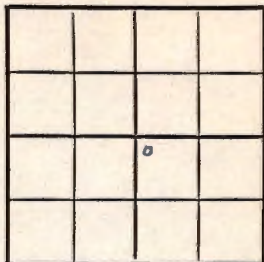

Kearny County

RECORD

Location X

Rig up _____

Drilling and Remarks:

Cased _____ in., _____ ft.

Sand _____

Gas _____

Oil _____

Total Depth _____

PRODUCTION

1st 24 hrs. Nat. _____

1st 24 hrs. after shot _____

Gas _____ Cu. Ft.

Dry Hole _____

Abandoned _____

Date

MAR 30 1949 19

S. J. LEWIS Scout

Map No. ✓ Sec. 11 Twp. 25 R. 34W

Well No. 3 Brown

Northern Natural Gas Company

COMPLETE

Contractor

NW SE

E 12942


SECTION PLAT

100 Ft. from N. Line

 Ft. from S. Line

 Ft. from E. Line

100 Ft. from W. Line

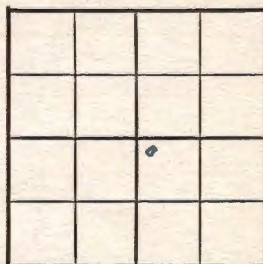

Finney County

Location

Rig up

Drilling and Remarks:

*7" @ 2003
218' of 5" Ref. line
@ 2702
15000 acid
22,841,000 Gall
429 R/R*

RECORD

Cased in., ft.

Sand

Gas

Oil

Total Depth 2702

PRODUCTION

1st 24 hrs. Nat.

1st 24 hrs. after shot

Gas Cu. Ft.

Dry Hole

Abandoned

Date

JUL 6 1949 19

S. J. LEWIS Scout