

KANSAS

Finney County


FORM 51 IOM 12-46 PETROL

Section 30 Township 25 Range 34-W

Well No. ²~~1~~ Reede

Company Helmerich & Payne & Champlin

Hugoton Pool

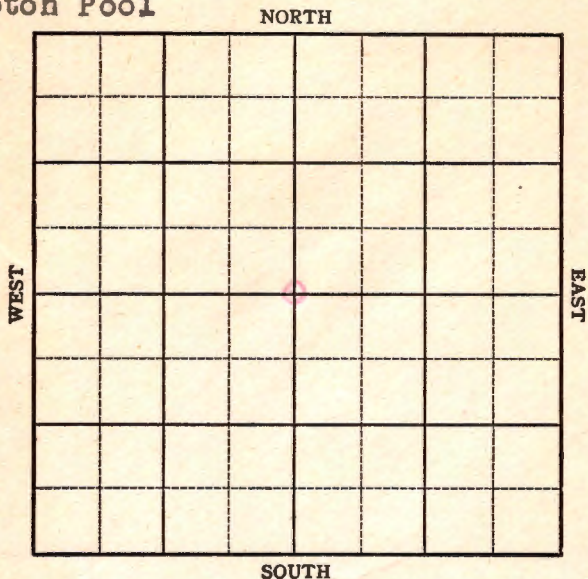

Sec. 30 Twp. 25 R. 34-W

Well No. #2. #1 Reede Farm

Helmerich & Payne & Champlin Company

Hugoton Pool

2640'


 Ft. from N. Line

 Ft. from S. Line

2640 Ft. from E. Line

 Ft. from W. Line

C Sec.

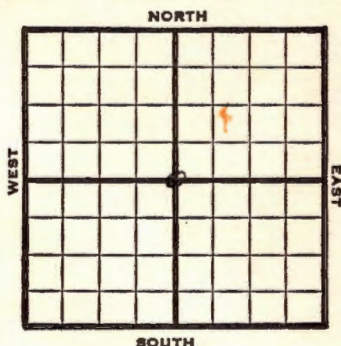

1947

REPORT

7/9 Location

7/16 10" @ 760'
WOC

7/22 TD 2680
7" @ 2680
RUST

7/29 "

8/6 72 shots 2503-21
64 shots 2526-42
116 shots 2556-84
60 shots 2630-47
42 shots 2665-76
15000 acid.

8/13 "

8/20 "

8/27 "

9/3 "

9/10 "

9/17 "

9/24 "

10/1 "

OVER

1947

10/8 7" @ 2680'

Perf.

15,000 Acid

11,988,000 Gas

TD 2680'

414# R Pr.

COMPLETED

Map No. _____ Sec. 30 Twp. 25 R. 34W

Well No. 1 Reade

Helmerich & Payne & Champlin Company

FIRST REPORT

Contractor _____

C Sec. _____


SECTION PLAT

2640 Ft. from N. Line

_____ Ft. from S. Line

2640 Ft. from E. Line

_____ Ft. from W. Line

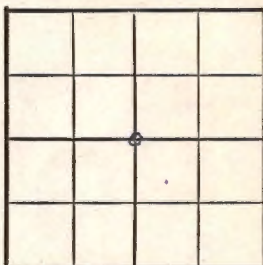

Finney County

Location X

Rig up _____

Drilling and Remarks:

RECORD

Cased _____ in., _____ ft.

Sand _____

Gas _____

Oil _____

Total Depth _____

PRODUCTION

1st 24 hrs. Nat. _____

1st 24 hrs. after shot _____

Gas _____ Cu. Ft.

Dry Hole _____

Abandoned _____

Date

JUL 9 1947 19 S. J. LEWIS Scout

Map No. 0 **Kansas** Sec. 30 Twp. 25 R. 34W

Well No. 2 Reede

Helmerich & Payne & Champlin Company

CORRECTION

Contractor

C Sec.


SECTION PLAT

2640 Ft. from N. Line

Ft. from S. Line

2640 Ft. from E. Line

Ft. from W. Line

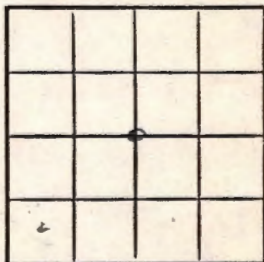

Finney County

Location _____

Rig up _____

Drilling and Remarks:

Reported as
#1 Reede

RECORD

Cased _____ in., _____ ft.

Sand _____

Gas _____

Oil _____

Total Depth _____

PRODUCTION

1st 24 hrs. Nat. _____

1st 24 hrs. after shot _____

Gas _____ Cu. Ft.

Dry Hole _____

Abandoned _____

Date

JUL 23 1947

19

S. J. LEWIS

Scout

Map No. 0 Sec. 30 Twp. 25 R. 34W

Well No. 2 Reede


Helmerich & Payne & Champl Company

COMPLETE

Contractor

C Sec.

SECTION PLAT

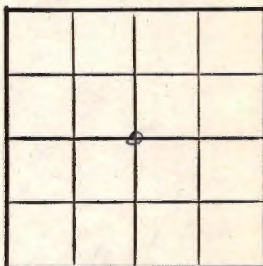

2640 Ft. from N. Line

 Ft. from S. Line

2640 Ft. from E. Line

 Ft. from W. Line

Finney County

Location

Rig up

Drilling and Remarks:

7" @ 2650

Perf.

15,000 acid

11,988,000 Gas

4 1/4" R/P

RECORD

Cased in., ft.

Sand

Gas

Oil

Total Depth 2650

PRODUCTION

1st 24 hrs. Nat.

1st 24 hrs. after shot

Gas Cu. Ft.

Dry Hole

Abandoned

Date

OCT 8 1947

S. J. LEWIS

Scout