


Section 21 Township 25 Range 34W

Well No. \$24 Brown

Company Northern Natural

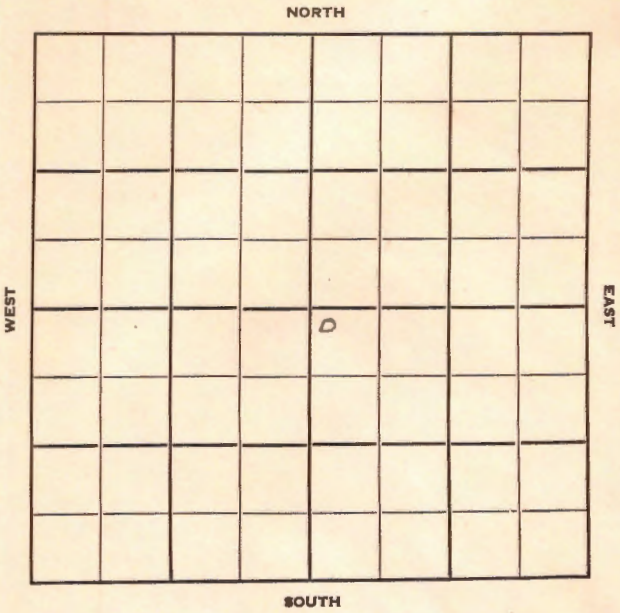

Sec. 21 Twp. 25 R. 34W ✓

Well No. #24 Brown Farm _____

Northern Natural Company _____

Hugoton Pool Contractor _____


440' Ft. from N. Line

_____ Ft. from S. Line

_____ Ft. from E. Line

200' Ft. from W. Line

NE SE

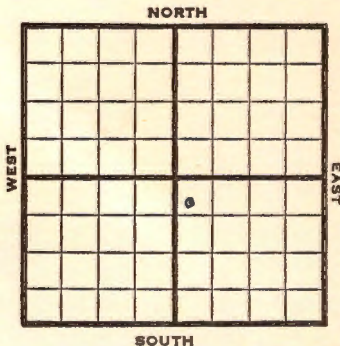

1950

Elev. 2965' REPORT

4/26

Spud 4-24-50
Drlg. 425'

5/31

10" @ 422
7" @ 2435

Hev 2435

Krider 2491

10,000A

comp 10,660,000 gas

Winfield 2520

Ft Riley 2575

COMPLETED

Map No. _____ Sec. 21 _____ Twp. 25 _____ R. 34W _____

Well No. 24 Brown _____

Northern Natural _____ Company

NW SE _____ E1.2965 / Contractor

SECTION / PLAT

440 _____ Ft. from N. Line

_____ Ft. from S. Line

_____ Ft. from E. Line

220 _____ Ft. from W. Line

Fix			
X			
COMPLETE			
		0	

Finney

Location _____

Rig up _____

Drilling and Remarks:

10" C 422

7" C 2435

Her. 2435

Krider 2491

Winfield 2520

7 ft. Riley 2575

RECORD

Cased _____ in., _____ ft.

Sand _____

Gas _____

Oil _____

Total Depth 2741

PRODUCTION

1st 24 hrs. Nat. _____

1st 24 hrs. after shot _____

Gas _____ Cu. Ft.

Dry Hole _____

Abandoned _____

19,600 A
Date Comp. 10,660,000 gas

MAY 31 1950 19

J. E. TYRA Scout