


Section 22 Township 25 Range 34W
Well No. #23 Brown
Company Northern Natural Gas

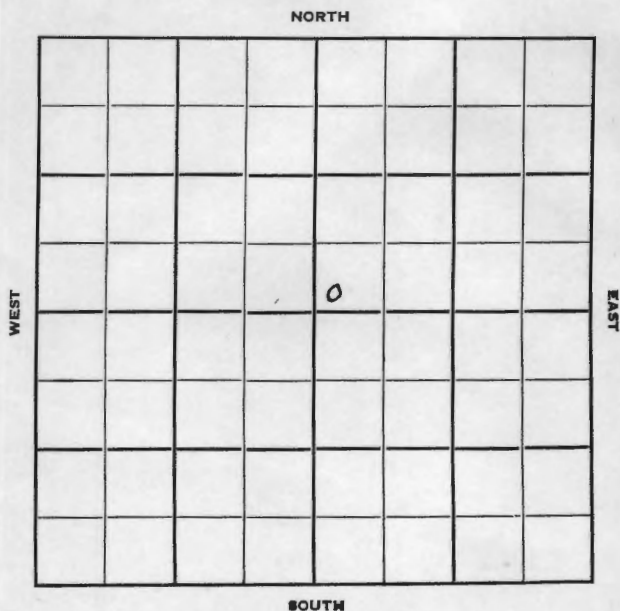

Sec. 22 Twp. 25 R. 34W

Well No. #23 Brown Farm

Northern Natural Gas Company

Contractor

Hugoton Pool


 Ft. from N. Line

200' Ft. from S. Line

 Ft. from E. Line

200' Ft. from W. Line

SW NE

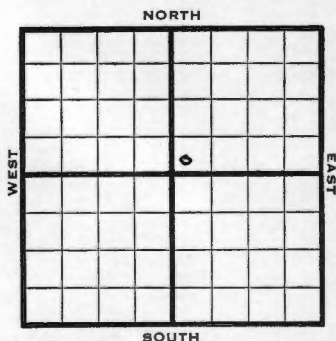

1950

Elev 2962

REPORT

4/19

RUR

5/17

10" @ 424

7" @ 2493

234' of 5" liner

Hevington 2495

Krider 2549

Odell 2575

Winn 2583

open flo 17,839,000 CFGPD

Completed

COMPLETED

Map No. _____ Sec. 22 Twp. 25 R. 34WWell No. 23 Brown_____
Northern Natural Gas Company_____
Contractor

SW NE

SECTION PLAT

_____
Ft. from N. Line200 Ft. from S. Line_____
Ft. from E. Line200 Ft. from W. Line

Finney County

Location _____

Rig up _____

Drilling and Remarks:

R U R

RECORD

Cased _____ in., _____ ft.

Sand _____

Gas _____

Oil _____

Total Depth _____

PRODUCTION

1st 24 hrs. Nat. _____

1st 24 hrs. after shot _____

Gas _____ Cu. Ft.

Dry Hole _____

Abandoned _____

Date

J. E. TYRA

APR 19 1950 19

Scout

Map No. _____ Sec. 22 Twp. 25 R. 34W

Well No. 23Brown

Northern Natural Gas Company

Contractor

SW NE


E1. 2962
SECTION PLAT

_____ Ft. from N. Line

200 Ft. from S. Line

_____ Ft. from E. Line

200 Ft. from W. Line

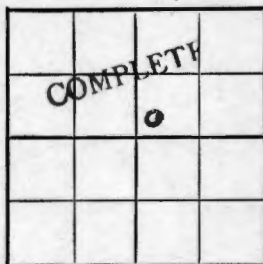

Finney

Location _____

Rig up _____

Drilling and Remarks:

10" @ 424
7" @ 2493
234' 95" liner
Kingston 2495
Knicker 2549
Odell 2575

RECORD

Cased _____ in., _____ ft.

Sand _____

Gas _____

Oil _____

Total Depth _____

PRODUCTION

1st 24 hrs. Nat. _____

1st 24 hrs. after shot _____

Gas _____ Cu. Ft.

Dry Hole _____

Abandoned _____

Win 2583
 Date _____

open flow
17,839,000 CFOPD

MAY 17 1950

19

J. E. TYRA Scout