


Section 24 Township 25 Range 34-W

Well No. #9 Spratt

Company Kansas Natural Gas

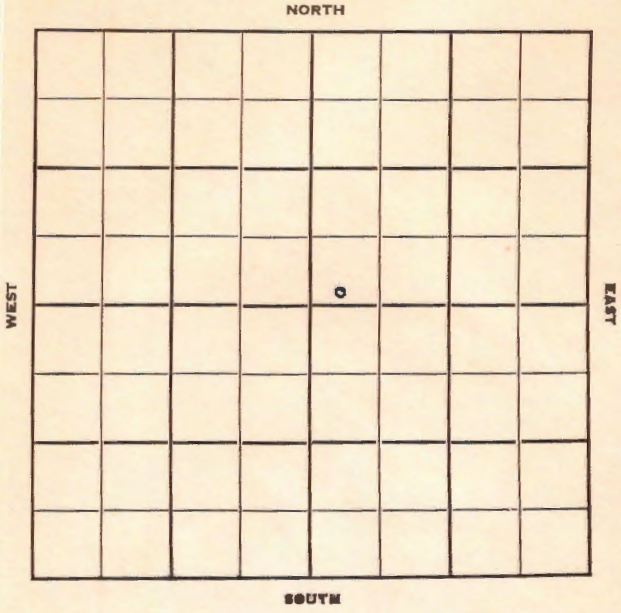

Sec. 24 Twp. 25 R. 34W ✓

Well No. #9 Spratt Farm

Kansas Natural Gas Company

Contractor

Hogoton


Ft. from N. Line

100 Ft. from S. Line

Ft. from E. Line

300 Ft. from W. Line

SW NE

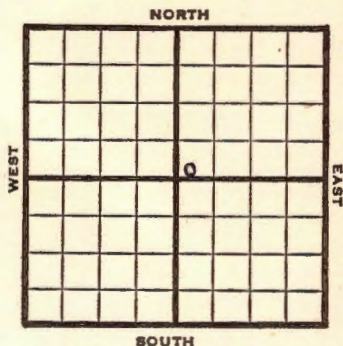

1950

Elev 2952

REPORT

5/10

Location

7/19

10" @ 560

7" @ 2700

132/2644-76, 120/2548-68, 132/2522-4400

74/2594-2600

38000 total acid

Her 2523

Krider 2550

Win 2585

Towanda 2654

Comp 14,892,000 gas 381#

TD 2700

Completed

COMPLETED

Kansas

Hugoton

Map No. _____ Sec. 24 Twp. 25 R. 34W

Well No. 9 Spratt

Kansas Natural Gas Company

_____ Contractor

SW NE

SECTION PLAT

_____ Ft. from N. Line

100 Ft. from S. Line

_____ Ft. from E. Line

300 Ft. from W. Line

		o	
FIRST REPORT			

Finney

Location _____

Rig up _____

Drilling and Remarks:

RECORD

Cased _____ in., _____ ft.

Sand _____

Gas _____

Oil _____

Total Depth _____

PRODUCTION

1st 24 hrs. Nat. _____

1st 24 hrs. after shot _____

Gas _____ Cu. Ft.

Dry Hole _____

Abandoned _____

Date

MAY 10 1950 19

J. E. TYRA Scout

~~Kansas~~

Hugoton Pool

Map No. _____ Sec. 24 Twp. 25 R. 34W

Well No. 9 Spratt

Kansas Natural Gas Company

Contractor

SW NE


E1. 2952
SECTION PLAT

_____ Ft. from N. Line

100 Ft. from S. Line

_____ Ft. from E. Line

300 Ft. from W. Line

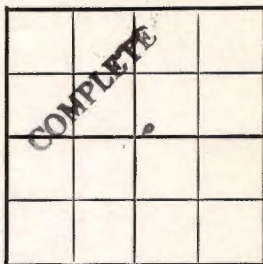

Finney Cou ty

Location _____

Rig up _____

Drilling and Remarks:

10" @ 560

7" @ 2700

132/ 2644-76

120/ **2548-68**

132/ 2522-44

74/ 2594-2600

38000 total acid

RECORD

Cased _____ in., _____ ft.

Sand _____

Gas _____

Oil _____

Total Depth 2700

PRODUCTION

1st 24 hrs. Nat. _____

1st 24 hrs. after shot _____

Gas _____ Cu. Ft.

Dry Hole _____

Abandoned _____

Date

JUL 10 1950

J. E. TYRA Scout

Her. 2523

Krider 2550

Win. 2585

Towanda 2654

Comp. 14,892,000

1956 561

181

mt

Scout Cards

Land Small Map

Land Wall Map

Tracings

France Map

Pierce Map

Misc.












