


KANSAS

Section 25 Township 25 Range 34-W

Well No. #3 McCoy

Company Northern Natural

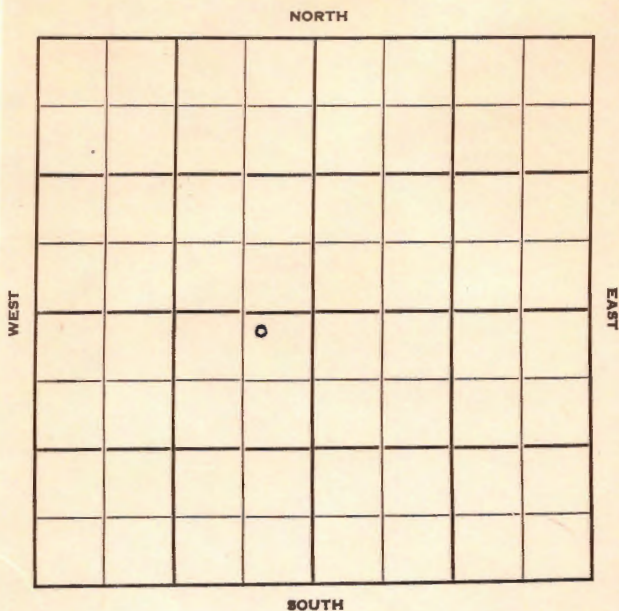

Finney

KANSAS

Sec. 25 Twp. 25 R. 34W ✓

Well No. #3 McCoy Farm _____

Northern Natural Company _____

Contractor _____


200' Ft. from N. Line

_____ Ft. from S. Line

600' Ft. from E. Line

_____ Ft. from W. Line

200 S 600 W of C

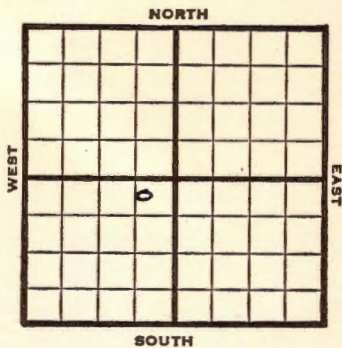

1950

Elev 2962

REPORT

5/17

Location

6/14

10" @ 422

7" @ 2509

TD 2721

230' of 5" liner

21000 acid

Her. 2505

Krider 2540

Win. 2595-2628

Ft. Riley 2652

TD 2721

Comp 20,384,000 gas

Completed

COMPLETED

Map No. _____ Sec. 25 Twp. 25 R. 34W

Well No. 3 Mc Coy

Northern Natural Company

Contractor

200S 600W of C

SECTION PLAT

200 Ft. from N. Line

_____ Ft. from S. Line

600 Ft. from E. Line

_____ Ft. from W. Line

FIRST REPORT			
	0		

Finney

Location X

Rig up _____

Drilling and Remarks:

RECORD

Cased _____ in., _____ ft.

Sand _____

Gas _____

Oil _____

Total Depth _____

PRODUCTION

1st 24 hrs. Nat. _____

1st 24 hrs. after shot _____

Gas _____ Cu. Ft.

Dry Hole _____

Abandoned _____

Date

MAY 17 1950

19

J. E. TYRA

Scout

Kansas

Map No. _____ Sec. 25 Twp. 25 R. 34W

Well No. 3 McCoy

Northern Natural Company

Contractor

NE SW

E1. 2962
SECTION PLAT

200

Ft. from N. Line

Ft. from S. Line

600

Ft. from E. Line

Ft. from W. Line

COMPLETE

Finney County

Location _____

Rig up _____

Drilling and Remarks:

10" @ 422

7" @ 2509

TD 2721

220# of 5" liner

21000 acid

RECORD

Cased _____ in., _____ ft.

Sand _____

Gas _____

Oil _____

Total Depth _____

PRODUCTION

1st 24 hrs. Nat. _____

1st 24 hrs. after shot _____

Gas _____ Cu. Ft.

Dry Hole _____

Abandoned _____

Date

JUN 14 1950 19

J. E. TYRA Scout

Her. 2505
 Krider 2540
 Win. 2595-2628
 Ft. Riley 2652
 TD 2721
 Comp. 20,384,000

Misc.
 Pierce Map
 France Map
 Tracings
 Land Wall Map
 Land Small Map
 Scout Cards

7W

JUN 19 1950

Produced and published by
 the
 Geological Survey

PRODUCTION
 Original
 Oil
 Gas
 Sand
 Coal

SECTION



SECTION 16.74

CONTRACT

CONTRACT

MAP NO.

MAP NO.

FORM NO. 100-11-10-1-10