

KANSAS

Finney

Section 28 Township 25 Range 34W

Well No. 13 Brown

Company Northern Natural Gas

Hugoton

NORTH

WEST

EAST

				0			

SOUTH

Finney **KANSAS**

Sec. 28 Twp. 25 R. 34W ✓

Well No. #13 Brown Farm _____

Northern Natural Gas Company
Hugoton Pool (Moran, Cont.)

NORTH


_____ Ft. from N. Line

200' Ft. from S. Line

_____ Ft. from E. Line

200' Ft. from W. Line

SW NE

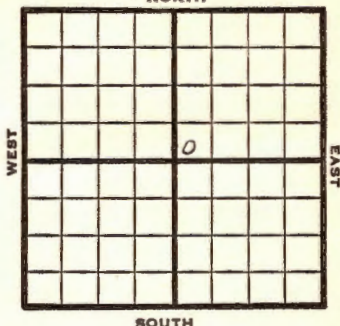

SOUTH

1949

Elev 2975'

R E P O R T

6/7

Location

6/15

"

6/21

10" @ 525'

TD 2500'

Run 7"

6/28

7" @ 2483'

Drlg. 2600'

7/6

TD 2710'

21000 acid

7/12

"

7/20

"

7/27

231' of 5" Perf Liner @ 2710'

8/3

"

8/10

TD 2710'

7" @ 2483'

231' of 5" Perf Liner @ 2710'

21000 acid

19,128,000 Gas

406# R Pr.

Comp

COMPLETED

Finney County Kansas State

Map No. _____ Sec. 28 Twp. 25 R. 34W

Well No. 13 Brown

Northern Natural Gas Company

Moran Contractor

SW NE

FIRST REPORT SECTION PLAT

_____ Ft. from N. Line

200 Ft. from S. Line

_____ Ft. from E. Line

200 Ft. from W. Line

Hugoton Pool

Remarks:

Location

Date JUN 8 1949

Scout S. J. LEWIS

ansas

Map No. ✓ Sec. 28 Twp. 25 R. 34WWell No. 13 Brown

Northern Natural Gas

Company

COMPLETE

Contractor

SW NE

E1, 2925
SECTION PLAT

Ft. from N. Line


200

Ft. from S. Line

Ft. from E. Line

200

Ft. from W. Line

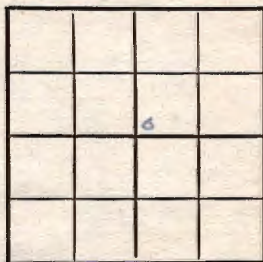

Finney County

RECORD

Location

Cased _____ in, _____ ft.

Rig up

Sand

Drilling and Remarks:

Gas

Oil

Total Depth 2714

PRODUCTION

1st 24 hrs. Nat.

1st 24 hrs. after shot

Gas _____ Cu. Ft.

Dry Hole

Abandoned

Date

AUG 10 1949 19

S. J. LEWIS

Scout