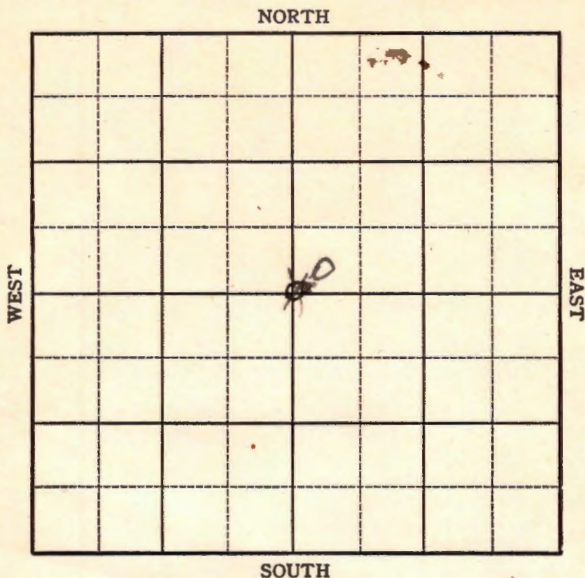


KANSASSection 3 Township 25 Range 35-WWell No. #1 ~~#2~~ TateCompany Osborne etal

KANSAS

Kearney ✓

Sec. 3 Twp. 25 R. 35W

Well No. #1 ~~#2 Tate~~ Farm

Oshorne ETAL Company

Hugoton


~~2640~~ Ft. from N. Line

200 Ft. from S. Line

~~2640~~ Ft. from E. Line

200 Ft. from W. Line

~~C Sec.~~ SW NE

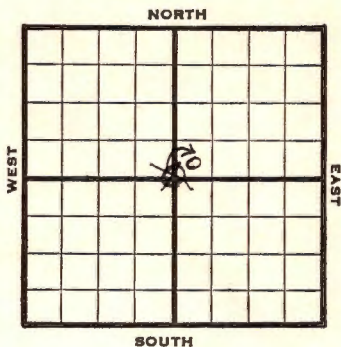

1946

Elev 2996

REPORT

10/9

RUR

10/15

10" @ 563'

Drlg 1080'

10/22

Drlg 2400'

10/29

TD 2680,

Run 5"

11/6

" "

11/12

" "

11/20

2680 fsg.

11/27

" "

12/3

" "

12/10

TD 2706'

12/17

672 shots 2428-2623'

1947

1/4

Total 49000 acid

1/8

" "

1/15

" "

1/21

" "

OVER

1/29

TD 2706'

7" @ 2682

Perf

49000 Acid

33,500,000 Gas

396# R Pr

COMPLETED

KANSAS
Kansas

Hugoton Pool

Map No. _____ Sec. 3 Twp. 25 R. 35WWell No. 1 Tate

Osborne etal.

Company

CORRECTION

Contractor

SW NE

SECTION PLAT

_____ Ft. from N. Line

200 Ft. from S. Line

_____ Ft. from E. Line

200 Ft. from W. Line

Kearny County

Location _____

Rig up _____

Drilling and Remarks:

Reported

#2 Tate C sec.

RECORD

Cased _____ in., _____ ft.

Sand _____

Gas _____

Oil _____

Total Depth _____

PRODUCTION

1st 24 hrs. Nat. _____

1st 24 hrs. after shot _____

Gas _____ Cu. Ft.

Dry Hole _____

Abandoned _____

Date

OCT 1 6 1946

19

S. J. LEWIS

Scout


KANSAS

Kansas Hugoton

Map No. _____ Sec. 3 Twp. 25 R. 35WWell No. 2 Tate_____Osborne Etal._____
Company_____FIRST REPORT_____
Contractor

C Sec.

SECTION PLAT

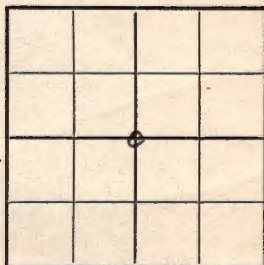2640 Ft. from N. Line_____
Ft. from S. Line2640 Ft. from E. Line_____
Ft. from W. LineKearny County

Location _____

Rig up _____

Drilling and Remarks:

R U R

RECORD

Cased _____ in., _____ ft.

Sand _____

Gas _____

Oil _____

Total Depth _____

PRODUCTION

1st 24 hrs. Nat. _____

1st 24 hrs. after shot _____

Gas _____ Cu. Ft.

Dry Hole _____

Abandoned _____

Date

OCT 9 1946 19S. J. LEWIS Scout

Map No. _____ Sec. 3 Twp. 25 R. 35W

Well No. 1 Tate

Osborne et al.


Company

COMPLETE

Contractor

SW NE

E12996
SECTION PLAT

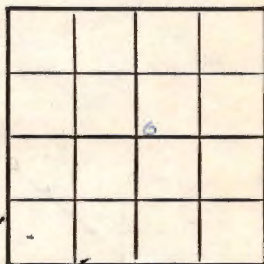

_____ Ft. from N. Line

200 Ft. from S. Line

_____ Ft. from E. Line

200 Ft. from W. Line

Kearny County

Location _____

Rig up _____

Drilling and Remarks:

7" Q26R

Ref.

49000 acid

33,500,000 Gal

*396 * R/B*

RECORD

Cased _____ in. _____ ft.

Sand _____

Gas _____

Oil _____

Total Depth 2706

PRODUCTION

1st 24 hrs. Nat. _____

1st 24 hrs. after shot _____

Gas _____ Cu. Ft.

Dry Hole _____

Abandoned _____

Date

JAN 29 1947 19

S. J. LEWIS

Scout