


KANSAS

Section 5 Township 25 Range 35W

Well No. 1 Frost

Company Kansas Natural Gas

MISCELLANEOUS
NORTH

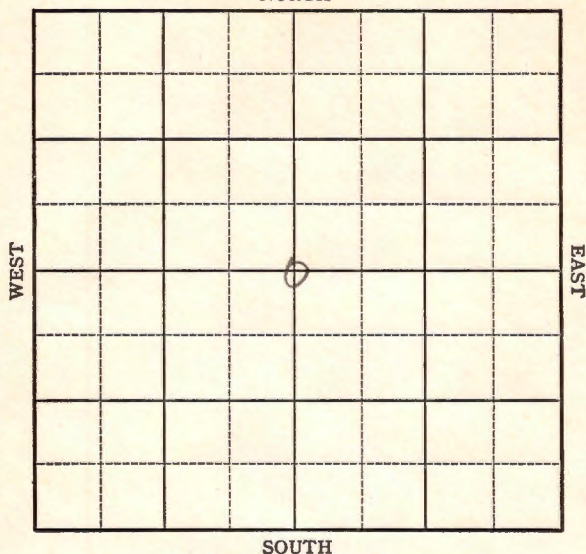

Kearny

KANSAS

Sec. 5 Twp. 25 R. 35-W

Well No. #1 Frost Farm

Kansas Natural Gas Company


(Miscellaneous)

2640 Ft. from N. Line

 Ft. from S. Line

2640 Ft. from E. Line

 Ft. from W. Line

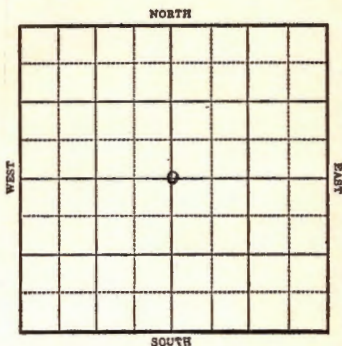

1942 ELEV. 2980 R E P O R T

10/14 Location

10/21 "

10/28 "

11/4 "

11/11 "

11/18 "

11/24 "

12/2 "

12/9 "

12/16 10" @ 480
WOC

12/22 TD 2550' Run 7"

12/29 " " "

1943

1/6 " " "

1/13 8" Casing set 2550 RUST.
1/20 " " " "

1/27 7" Casing set 2417 Corrected
Drlg. 2535-2 $\frac{1}{2}$ M. Gas.

2/3 1500 gal acid

2/10 " " "

2/24 " " "

OVER

1943

2/17 TD 2652
2,518,000 Gas.

3/3 " " " "

3/10 " " " "

3/17 " " "

3/24 Sand 2550
7" @ 2417'
T.D. 2652'
11,500 gal. acid
25,335,000 cu. ft. gas.

COMPLETED


Kearny

KANSAS

Map No. 422 Sec. 5 Twp. 25 R. 35WWell No. 1 FrostKansas Natural Gas Company
FIRST REPORT
Contractor

C Sec.

SECTION PLAT

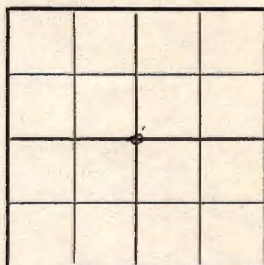2640 Ft. from N. Line Ft. from S. Line2640 Ft. from E. Line Ft. from W. Line

MISCELLANEOUS

Location XXXRig up

Drilling and Remarks:

RECORD

Cased in., ft.Sand Gas Oil Total Depth

PRODUCTION

1st 24 hrs. Nat. 1st 24 hrs. after shot Gas Cu. Ft.Dry Hole Abandoned

Date

OCT 14 1942

19

S. J. LEWIS

Scout

KANSAS
 Map No. MM Sec. 5 Twp. 25 R. 35W

Well No. 1 Frost

Kansas Natural Gas Company

COMPLETED Contractor

C Sec.


SECTION PLAT

2640 Ft. from N. Line

_____ Ft. from S. Line

2640 Ft. from E. Line

_____ Ft. from W. Line

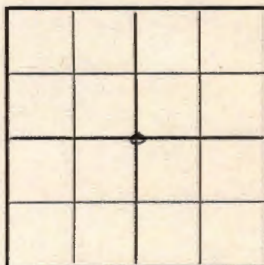

MISCELLANEOUS

Location _____

Rig up _____

Drilling and Remarks:

Sand 2550
7' @ 2400 @ 2550
11500 acid
25,335,000 cu ft
Gas.

RECORD

Cased _____ in., _____ ft.

Sand _____

Gas _____

Oil _____

Total Depth 2652

PRODUCTION

1st 24 hrs. Nat. _____

1st 24 hrs. after shot _____

Gas _____ Cu. Ft.

Dry Hole _____

Abandoned _____

Date

MAR 24 1943

19

S. J. LEWIS

Scout