


KANSAS

Kearny

Section 7 Township 25 Range 35-W

Well No. 2 Campbell

Company Tri-County Gas

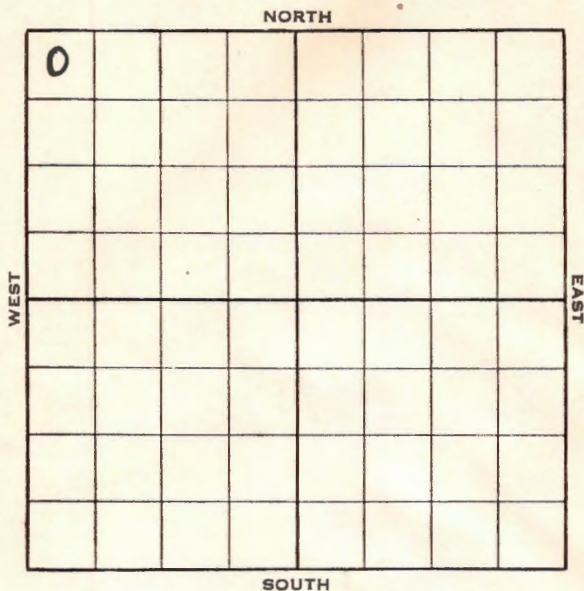

Kearny KANSAS

Map No. NM Sec. 7 Twp. 25 R. 35WWell No. 2 CampbellTri-County Gas

Company

FIRST REPORT

Contractor

NW/C

330 Ft. from N. Line Ft. from S. Line Ft. from E. Line330 Ft. from W. Line**SECTION PLAT**

0			

Location Rig up

Drilling and Remarks:

10"-5487" - 2436WOC**RECORD**Cased in., ft.Sand Gas Oil Total Depth **PRODUCTION**1st 24 hrs. Nat. 1st 24 hrs. after shot Gas Cu. Ft.Dry Hole Abandoned

Date

APR 6 - 1938

19

H. D. Hatfield

Scout

Kearny

KANSAS

Map No. NM Sec. 7 Twp. 25 R. 35WWell No. 2 CampbellTri-County Gas

Company

Contractor

COMPLETED

NW/C

330 Ft. from N. Line

_____ Ft. from S. Line

_____ Ft. from E. Line

330 Ft. from W. Line

SECTION PLAT

0			

Location _____

Rig up _____

Drilling and Remarks:

PB 2685
7000 and
9 M gas

RECORD

Cased 7 in., 2436 ft.Sand ?

Gas _____

Oil _____

Total Depth 2730

PRODUCTION

1st 24 hrs. Nat. _____

1st 24 hrs. after shot _____

Gas _____ Cu. Ft.

Dry Hole _____

Abandoned _____

Date

APR 27 1938 19

H. D. Hatfield Scout