


KANSAS**Kearny**Section 13 Township 25 Range 35WWell No. #1 U S A - DeanCompany Magnolia**Hugoton Pool**

NORTH

WEST

EAST

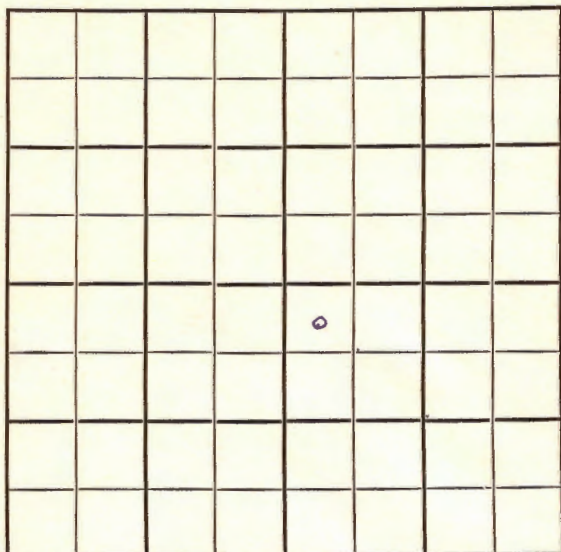

SOUTH

KANSAS

Kearny

Sec. 13 Twp. 25 R. 35W ✓Well No. #1 U S A - Dean Farm

Magnolia

Company

Hugoton


330' Ft. from N. Line

Ft. from S. Line

Ft. from E. Line

330' Ft. from W. Line

NW SE

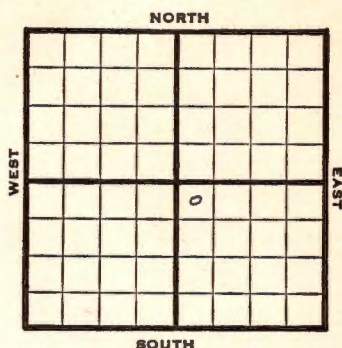

1948

Elev. 2984'

REPORT

3/24

Location

3/31

"

4/7

"

4/14

10" @ 859'

WOC

4/21

Drlg. 2413'

4/28

TD 2744'

7" @ 2744'

RUST

5/5

"

5/12

96 shots 2654-76'

7000 acid.

5/19

144 shots 2602-34 - 7000 acid

72 "

2550-68

"

"

48 "

2510-22

"

"

72 "

2484-98

"

"

6/1

7" @ 2744'

Perf.

Acid 34,000

Gas 20,800,000

R. Pr. 400#

TD 2744'

COMPLETED

Map No. _____ Sec. 13 Twp. 25 R. 35W

Well No. 1 U S A - Dean

Magnolia _____ Company

FIRST REPORT _____ Contractor

NW SE


SECTION PLAT

330 Ft. from N. Line

_____ Ft. from S. Line

_____ Ft. from E. Line

330 Ft. from W. Line

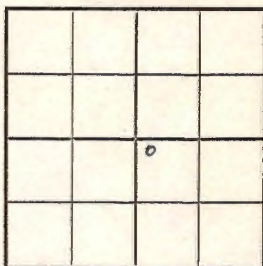

Kearny County

Location X

Rig up _____

Drilling and Remarks:

RECORD

Cased _____ in., _____ ft.

Sand _____

Gas _____

Oil _____

Total Depth _____

PRODUCTION

1st 24 hrs. Nat. _____

1st 24 hrs. after shot _____

Gas _____ Cu. Ft.

Dry Hole _____

Abandoned _____

Date

MAR 24 1948 19 S. J. LEWIS Scout

Map No. _____ Sec. 13 Twp. 25 R. 35 W

Well No. 1 U S A - Dean

Magnolia _____ Company

COMPLETE

Contractor

NW SE

E 1 2984
SECTION PLAT

		0	

330 Ft. from N. Line

_____ Ft. from S. Line

_____ Ft. from E. Line

330 Ft. from W. Line

Hearny County

Location _____

Rig up _____

Drilling and Remarks:

7" @ 2744

Pay.


20,800,000 Gas

400 R 13*

RECORD

Cased _____ in., _____ ft.

Sand _____

Gas _____

Oil _____

Total Depth 2744

PRODUCTION

1st 24 hrs. Nat. _____

1st 24 hrs. after shot _____

Gas _____ Cu. Ft.

Dry Hole _____

Abandoned _____

Date

JUN 1 1948

19

S. J. LEWIS

Scout